|                                   | <b>State Well Report</b>                        |                      |
|-----------------------------------|---|----------------------|
| $\bigcirc$ $\land$                |   | For Office Use Only: |
| County: Desoto                    | Part 1 – Driller's Log                          |                      |
|                                   | Mississippi Department of Environmental Quality | Aquifer:             |
| Permit #:                         | Office of Land and Water Resources              | 4-201                |
| Driller: Jones WMason             | P.O. Box 10631                                  | Well #:              |
|                                   | Jackson, MS 39289-0631                          | L. S. Elevation:     |
| Date drilling completed: 11-15-07 | (601)961-5210                                   |                      |
|                                   | (601)354-6938 (fax)                             | E-log #:             |

State Law requires that this report be prepared by the license holder responsible for the work and filed with the Department at the above address within 30 days of completion of drilling of the well or borehole.

| Information on Well Owner  | Well or Borehole Location   |  |  |  |  |
|--|---|--|--|--|--|
| (Landowner if borehole is not for a water well)  | 31, 52,777 89,18.912  |  |  |  |  |
| Owner Name Art Ash   | Latitude: <u>34° 53,277</u> Longitude <u>89°48</u> ,962,<br>Method of Lat/Long (circle one): Conventional Survey, |  |  |  |  |
| Mailing Address: 9803 - Bethel rd.   |   |  |  |  |  |
|  | USGS quad, Hand-held GPS, Survey-grade GPS  |  |  |  |  |
|  | NE 1/ NW /4 Sec 27 Twn 25 Rng Low   |  |  |  |  |
| City State Zip Code  | Distance Direction Nearest Town   |  |  |  |  |
| Telephone No. (901) 481-1358   | Distance Direction Nearest Town<br>Miles SE of (Edoruce)  |  |  |  |  |
| Telephone No. ( <u>707) 787 7558</u>   |   |  |  |  |  |
| Well / Borg  | hole Data   |  |  |  |  |
| Date drilling started: $11-15-07$ Date drilling completed: $11-15-07$ Hole depth: $170'$ Hole diameter: $63/4$   |   |  |  |  |  |
| Location of the source of any surface water used for drilling:   | 14  |  |  |  |  |
| Location of the source of any surface water used for drilling:A<br>Method of dosing and volume of Chlorine used in drilling and development:A              |   |  |  |  |  |
| Logs run (circle all applicable): No log run Electric Gamma Ray Density Sonic Neutron Other:   |   |  |  |  |  |
| Purpose of borehole (check one): Water WellGeotechnical/Geological Investigation Ground Source Heat Pump   |   |  |  |  |  |
| Seismic Survey Other ( <i>describe</i> )   |   |  |  |  |  |
| If drilling is not related to water well construction  | n, skip the remainder of this block   |  |  |  |  |
| Purpose of Well (check one): Home 🖌 Industrial Public Supply Irrigation Fish Culture Other:  |   |  |  |  |  |
| If a flowing well, method of flow regulation: Valve NA Other (describe)  |   |  |  |  |  |
| Static Water Level: 65 feet above or below (pircle one) land surface Date measured: 😤 11-17-07   |   |  |  |  |  |
| Method of Measurement (circle one) steel tape electric tape air line other: String (wreight  |   |  |  |  |  |
| Well depth: 100' Well grouted to a depth of 10 feet Type of grout (circle one): Neat Cement Bentonite Mix  |   |  |  |  |  |
| Casing length: 150 feet Casing diameter: 4 inches Type of casing: 150  |   |  |  |  |  |
| Screen length: $\frac{\partial \circ}{\partial \circ}$ feet Screen diameter: $\underline{\neg}$ inches Type of screen: $\rho \circ \underline{\leftarrow}$ |   |  |  |  |  |
| Screen slot size:inches Setting depth: Fromfeet tofeet   |   |  |  |  |  |
| Type of completion (circle all applicable): Gravel packed Underreamed Telescoped Open hole Natural Development   |   |  |  |  |  |
| Other (describe):  |   |  |  |  |  |
| Top of lap pipe or reduction in casing:feet. If telescoped or more than one screen, describe on next page  |   |  |  |  |  |

Form: OLWR-SWR-1A

DEC 17 2007 BY: OLWR

H-201


## The sketch below only required for water wells

If well telescopes, show depths on sketch. Ground Level-

## Description of formations encountered must be provided for all wells and boreholes, unless specifically exempted by regulations

| Description of Formations Encountered | From (depth) | To (depth) |
|---------------------------------------|--------------|------------|
| Cley dist                             | Ground Level | 30         |
| led sort                              | 30           | 55         |
| 19000                                 | 55           | 61         |
| while sound                           | 61           | 10         |
| per grovel                            | 20           | 90         |
| white clay                            | 90           | (10        |
| white send                            | 110          | 100        |
|                                       |              |            |
|                                       |              |            |
|                                       | _            |            |
| ·                                     |              |            |
|                                       |              |            |
|                                       |              |            |
|                                       |              |            |
|                                       |              | _          |
|                                       |              |            |
|                                       |              |            |
|                                       |              |            |
|                                       |              | _l         |

If more than one screen, show location of each on sketch

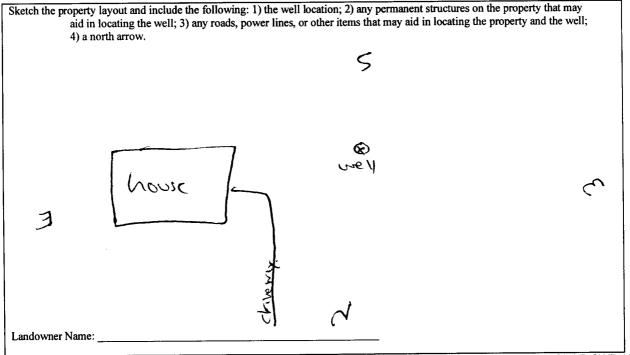

Form: OLWR-SWR-1A

I certify that the well/borehole was drilled, constructed, and completed in accordance with all applicable requirements of the Mississippi Department of Environmental Quality and the Mississippi Department of Health regulations, if applicable, and state laws.

Date

0-670 W Mosco  $\mathcal{D}$ e٦

12-12-07.

Signature of Licensee

Print Name of Responsible Licensee and License No.

RECEIVED DEL 17 2007 BY: OLWP

| STATE WELL REPORT   |             |  |  |  |  |
|---|-------------|--|--|--|--|
| County:     Desette       Permit #:     Pump Installer's Constrained of Office of Land and P.O. Box       Driller:     Desetted:       Date completed:     (1-17-2)   |             | Completion Report<br>of Environmental Quality<br>ad Water Resources<br>ox 10631<br>S 39289-0631<br>061-5210<br>I-6938 (fax)<br>ontractor or a licensed pump in<br>the above address within 30 da   | For Office Use Only:<br>Aquifer:<br>Well #: <u>H-201</u><br>Elevation:<br>Estaller. A copy of Part 1 of the<br>tys of well completion.<br>Location |  |  |
| Owner Name: Art Ash<br>Mailing Address: <u>9803 Bathel rd.</u><br>Olive Breven Ms <u>38654</u><br>City State Zip Code   |             | Latitude: <u>34.53.277</u> Longitude: <u>89.48.962</u><br>Method of Lat/Long (check one): Conventional Survey,<br>USGS quad, Hand-held GPS, Survey-grade GPS<br><u>NE 14 NUV 14 Sec 27 T 25 R 6 VV</u>   |  |  |  |
| City         State         Zip Code           Telephone No. ( <u>SUI)         481 - 1358</u>  |             | Distance Direction   | Nearest Town<br>f <u>cedocaieaa</u>  |  |  |
| Pump Type<br>Circle one   | ~           |  | wer Type<br>ircle one  |  |  |
| Air Lift Jet  | Submersible | Diesel Engine Gasolin  | e Engine Natural Gas   |  |  |
| Bucket Piston   | Turbine     | Electric Motor Hand  | Tractor PTO  |  |  |
| Centrifugal   Rotary     Other (specify):   | י           | Windmill     Other (       Horse Power Rating of Motor       Setting Depth:     10       Number of Stages:     ( \lambda)  | <u>feet</u>  |  |  |
| Pump Test Data  |             | Method of Me   | asuring Water Level  |  |  |
| Date Well Tested: $11 - 17 - 07$ Static Water Level (A): $65$ Feet Below Land Surface         Pumping Water Level (B): $NA$ Feet Below Land Surface         Drawdown [(B) - (A)]: $NA$ Feet Below Land Surface         Test Pumping Rate: $300$ Gallons Per Minute         Duration of Pump Test (minimum 4 hours): $340$ hours |             | Circle one         Air Line       Electric Measuring Line       Steel Tape         Other (specify): $String [ seight]$ For flowing well, measured shut in head: $NA$ feet         Well yielded $O$ GPM with a drawdown of $MA$ feet after $O$ hours of pumping |  |  |  |
| I HEREBY CERTIFY that the above statements are true to the best of my knowledge.         Jores w. Mason 0-620         Print Name of Pump Installer and License No. (if applicable)             Signature of Pump Installer  |             |  |  |  |  |

\*

×

Form: OLWR-SWR-1B

DEC 17 387

BY: OLWR