
	State We	-	For Office Use Only:
County: Desato	Part 1 – Dr		
	Mississippi Department o		Aquifer: Well #: <u>H-207</u>
Permit #:		Office of Land and Water Resources P.O. Box 10631	
Driller: Jores w. Mason	Jackson, MS		L. S. Elevation:
Date drilling completed: <u>4-2-08</u>	(601)96		
	(601)354-0	6938 (fax)	E-log #:
State Law requires that this repo	rt be prepared by the licen	se holder responsible for i	he work and filed with the
Department at the above addres.	s within 30 days of comple	tion of drilling of the well	or borehole.
Information on Well Owner		Well or Borehole Location	
(Landowner if borehole is not for a water well)		Latitude: 34 .53 ,748	" Longitude: <u>לא • ייץ י</u> איי בייג גע איין איין איין איין איין איין איין איי
Owner Name Dorrell Corperter		<b>43</b> Method of Lat/Long (circle or	S &
Mailing Address: 2249 red Gonts rd.			_
		USGS quad, Hand-held GPS, Survey-grade GPS	
	,	NE 1/5W 1/4 Sec 20	Twn <u> </u>
Byhalia MS	- 38611		
Byhalia M5 38611 City State Zip Code		Distance Direction Nearest Town <u>112</u> Miles <u>SE</u> of <u>Miller</u>	
Telephone No. (90) 489 - 7.00	۲  -		
	Well / Boreho		
Date drilling started: $\frac{4-2-9e}{2}$ Date d	rilling completed: <u>4-2-08</u>	Hole depth: $(25')$	Hole diameter: 6314
	ten und fan duillinge 🔹 🕯 🕯	N	
Location of the source of any surface war Method of dosing and volume of Chlorin	ne used in drilling and develop	oment: M	
		D to C to Management	Othern
Logs run (circle all applicable): No log run Name of organization running log(s):			
Name of organization running log(s):	M		
	M		
Name of organization running log(s): Purpose of borehole (check one): Water V Seismic	Well <u>C</u> Geotechnical/Geolog	ical Investigation Ground	i Source Heat Pump
Name of organization running log(s): Purpose of borehole (check one): Water V Seismic		ical Investigation Ground	i Source Heat Pump
Name of organization running log(s): Purpose of borehole (check one): Water V Seismic	Well <u>Geotechnical/Geolog</u> Survey Other ( <i>describe</i> ) <u>d to water well construction</u> ,	skip the remainder of this bl	i Source Heat Pump
Name of organization running log(s): Purpose of borehole (check one): Water V Seismic <i>If drilling is not relate</i> Purpose of Well (check one): Home	Well <u>Geotechnical/Geolog</u> Survey Other ( <i>describe</i> ) <u>d to water well construction</u> , Industrial Public Supply	ical Investigation Ground skip the remainder of this bl Irrigation Fish Culture	I Source Heat Pump ock Other:
Name of organization running log(s): Purpose of borehole (check one): Water V Seismic If drilling is not relate Purpose of Well (check one): Home If a flowing well, method of flow regulation	Well <u>Geotechnical/Geolog</u> Survey Other ( <i>describe</i> ) <u>d to water well construction</u> , Industrial Public Supply ion: Valve <u>M</u> Oth	cical Investigation Ground skip the remainder of this bl Irrigation Fish Culture her (describe)	I Source Heat Pump ock Other:
Name of organization running log(s): Purpose of borehole (check one): Water V Seismic If drilling is not relate Purpose of Well (check one): Home If a flowing well, method of flow regulation Static Water Level: ( >feet a	Well <u>Geotechnical/Geolog</u> Survey Other ( <i>describe</i> ) <u>d to water well construction</u> , Industrial Public Supply ton: Valve <u>M</u> Other above of Gelow (circle one) lar	ical Investigation Ground skip the remainder of this bl Irrigation Fish Culture er (describe) nd surface Date measured:	d Source Heat Pump <u>ock</u> Other: Other:
Name of organization running log(s): Purpose of borehole (check one): Water V Seismic If drilling is not relate Purpose of Well (check one): Home If a flowing well, method of flow regulation Static Water Level: ( >feet a	Well <u>Geotechnical/Geolog</u> Survey Other ( <i>describe</i> ) <u>d to water well construction</u> , Industrial Public Supply ton: Valve <u>M</u> Other above of Gelow (circle one) lar	ical Investigation Ground skip the remainder of this bl Irrigation Fish Culture er (describe) nd surface Date measured:	d Source Heat Pump <u>ock</u> Other: Other:
Name of organization running log(s): Purpose of borehole (check one): Water V Seismic If drilling is not relate Purpose of Well (check one): Home If a flowing well, method of flow regulation Static Water Level: Method of Measurement (circle one)	Well       Geotechnical/Geolog         Survey       Other (describe)         d to water well construction,         Industrial       Public Supply         ion:       Valve       M         ubove or below (circle one) lar         steel tape       electric tape	tical Investigation Ground <u>skip the remainder of this bl</u> Irrigation Fish Culture ther (describe) nd surface Date measured: air line other: <u>5</u>	d Source Heat Pump ock Other: 4-7-08 Ting (weight
Name of organization running log(s): Purpose of borehole (check one): Water W Seismic If drilling is not relate Purpose of Well (check one): Home If a flowing well, method of flow regulation Static Water Level: Method of Measurement (circle one) Well depth: 175 Well grouted to a construction Well depth: 175 Well grouted to a construction 175 Well grouted to a cons	Well       Geotechnical/Geolog         Survey       Other (describe)         d to water well construction,         Industrial       Public Supply         ion:       Valve       M         obove or below (circle one) lar         steel tape       electric tape         lepth of       (V) feet       Type or	tical Investigation Ground <u>skip the remainder of this bl</u> Irrigation Fish Culture ther (describe) nd surface Date measured: air line other: f grout (circle one): Neat Cen	d Source Heat Pump <u>ock</u> Other: <u>Underset</u> <u>Underset</u> <u>Cincy (weight</u> nent Bentonite) Mix
Name of organization running log(s): Purpose of borehole (check one): Water V Seismic If drilling is not relate Purpose of Well (check one): Home If a flowing well, method of flow regulation Static Water Level: Method of Measurement (circle one)	Well       Geotechnical/Geolog         Survey       Other (describe)         d to water well construction,         Industrial       Public Supply         ion:       Valve       M         obove or below (circle one) lar         steel tape       electric tape         lepth of       (V) feet       Type or	tical Investigation Ground <u>skip the remainder of this bl</u> Irrigation Fish Culture ther (describe) nd surface Date measured: air line other: f grout (circle one): Neat Cen	d Source Heat Pump <u>ock</u> Other: <u>Underset</u> <u>Underset</u> <u>Cincy (weight</u> nent Bentonite) Mix
Name of organization running log(s): Purpose of borehole (check one): Water W Seismic If drilling is not relate Purpose of Well (check one): Home If a flowing well, method of flow regulation Static Water Level: Method of Measurement (circle one) Well depth: 175 Well grouted to a construction Well depth: 175 Well grouted to a construction 175 Well grouted to a cons	Well <u>Geotechnical/Geolog</u> Survey Other ( <i>describe</i> ) <u>d to water well construction</u> , Industrial Public Supply ton: Valve <u>M</u> Oth above or below (circle one) lar steel tape electric tape lepth of <u>V</u> feet Type or ing diameter: <u>4</u>	tical Investigation Ground <u>skip the remainder of this bl</u> Irrigation Fish Culture ther (describe) the surface Date measured: air line other: <u>5</u> f grout (circle one): Neat Cent inches Type of casing:	d Source Heat Pump
Name of organization running log(s): Purpose of borehole (check one): Water V Seismic If drilling is not relate Purpose of Well (check one): Home If a flowing well, method of flow regulation Static Water Level: (2) feet a Method of Measurement (circle one) Well depth: 125 Well grouted to a construction Casing length: 10 feet Screen	Well       Geotechnical/Geolog         Survey       Other (describe)         d to water well construction,         Industrial       Public Supply         ion:       Valve       M         obove of below (circle one) lar         steel tape       electric tape         lepth of       (V) feet       Type o         ing diameter:       4         uen diameter:       4	<pre>sical Investigation Ground skip the remainder of this bl  Irrigation Fish Culture er (describe) nd surface Date measured: air line other:<u>5</u> of grout (circle one): Neat Cen inches Type of casing: _inches Type of screen:</pre>	d Source Heat Pump
Name of organization running log(s): Purpose of borehole (check one): Water V Seismic If drilling is not relate Purpose of Well (check one): Home If a flowing well, method of flow regulation Static Water Level: (2) feet a Method of Measurement (circle one) Well depth: 125 Well grouted to a construction Casing length: 115 feet Case Screen length: 010 inches	Well       Geotechnical/Geolog         Survey       Other (describe)         d to water well construction,         Industrial       Public Supply         ion:       Valve       M         obove of below (circle one) lar         steel tape       electric tape         lepth of       (V) feet       Type o         ing diameter:       4         Setting depth:       From	<pre>sical Investigation Ground skip the remainder of this bit Irrigation Fish Culture er (describe) ad surface Date measured: air line other: f grout (circle one): Neat Cen inches Type of casing: _inches Type of screen: feet to</pre>	d Source Heat Pump
Name of organization running log(s): Purpose of borehole (check one): Water V Seismic If drilling is not relate Purpose of Well (check one): Home If a flowing well, method of flow regulation Static Water Level: (2) feet a Method of Measurement (circle one) Well depth: 125 Well grouted to a construction Casing length: 115 feet Case Screen length: 10 feet Screen	Well       Geotechnical/Geolog         Survey       Other (describe)         d to water well construction,         Industrial       Public Supply         ion:       Valve       M         toon:       Valve       M         toon:       Valve       M         toon:       Valve       M         toon:       Valve       Other         toon:       Valve       Index         toon:       Valve       Other         toon:       Valve       Index         toon:       Geotor       feet       Type o         ting diameter:	<pre>sical Investigation Ground skip the remainder of this bl Irrigation Fish Culture er (describe) end surface Date measured: air line other: f grout (circle one): Neat Cent inches Type of casing: inches Type of screen: inches Type of screen: end Telescoped Oper</pre>	d Source Heat Pump
Name of organization running $log(s)$ : Purpose of borehole (check one): Water V Seismic If drilling is not relate Purpose of Well (check one): Home $\checkmark$ If a flowing well, method of flow regulation Static Water Level: $(2 \rightarrow -)$ feet a Method of Measurement (circle one) Well depth: $125$ Well grouted to a construction Casing length: $115$ feet Case Screen length: $10$ feet Screen Screen slot size: $010$ inches Type of completion (circle all applicable)	Well       Geotechnical/Geolog         Survey       Other (describe)         d to water well construction,         Industrial       Public Supply         ion:       Valve       M         ion:       Valve       M         obove of below (circle one) lar       other         steel tape       electric tape         lepth of       (V) feet       Type o         ing diameter:       4         Setting depth:       From         Setting depth:       From         Other (describe):       M	<pre>sical Investigation Ground skip the remainder of this bit Irrigation Fish Culture er (describe) ad surface Date measured: air line other: f grout (circle one): Neat Cen inches Type of casing: inches Type of screen: inches Type of screen:</pre>	d Source Heat Pump ack Other: $4-3-00^{P}$ idy (weight) hent Bentonite Mix pul pul auc auc auc auc hole Natural Development
Name of organization running log(s): Purpose of borehole (check one): Water V Seismic If drilling is not relate Purpose of Well (check one): Home If a flowing well, method of flow regulation Static Water Level: (2) feet a Method of Measurement (circle one) Well depth: 125 Well grouted to a construction Casing length: 115 feet Case Screen length: 10 feet Screen slot size: 010 inches	Well       Geotechnical/Geolog         Survey       Other (describe)         d to water well construction,         Industrial       Public Supply         ion:       Valve       M         ion:       Valve       M         obove of below (circle one) lar       other         steel tape       electric tape         lepth of       (V) feet       Type o         ing diameter:       4         Setting depth:       From         Setting depth:       From         Other (describe):       M	<pre>sical Investigation Ground skip the remainder of this bit Irrigation Fish Culture er (describe) ad surface Date measured: air line other: f grout (circle one): Neat Cen inches Type of casing: inches Type of screen: inches Type of screen:</pre>	d Source Heat Pump ack Other: $4-3-00^{P}$ idy (weight) hent Bentonite Mix pul pul auc auc auc auc hole Natural Development

MAY 0 5 2008

BY: OLWR

H-207


## The sketch below only required for water wells

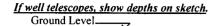

<u>Description of formations encountered must be provided for all</u> wells and boreholes, unless specifically exempted by regulations

From (depth)	To (depth)
	15
	30
30	125
	T
	1
	1
	1
	From (depth) Ground Level (5 30

If more than one screen, show location of each on sketch

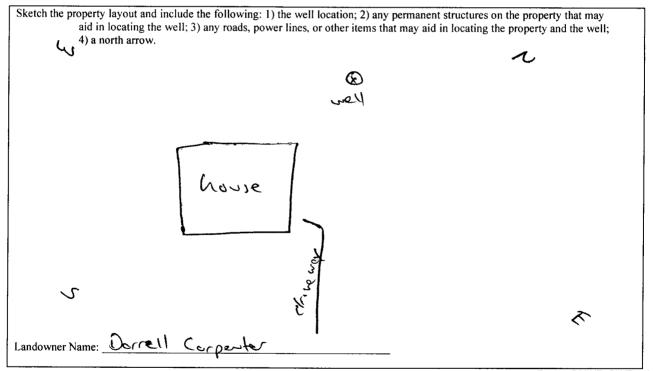

Form: OLWR-SWR-1A

I certify that the well/borehole was drilled, constructed, and completed in accordance with all applicable requirements of the Mississippi Department of Environmental Quality and the Mississippi Department of Health regulations, if applicable, and state laws.

4-98-08

, Mosen )oner

Print Name of Responsible Licensee and License No. Date

0-620

Signature of Licensee

MAY 0 5 2008

RECEIVED

**BY: OLWR** 

STATE WELL REPORT					
County: Desoto	Part 2 For Office Use Only:				
Pump Install	er's Completion Report nent of Environmental Quality Aquifer:				
Office of La	nd and Water Resources				
Jackson	O. Box 10631 n, MS 39289-0631 Well #: <u>H-207</u>				
Date completed: <u>44-08</u> (6	01)961-5210				
Copy information from block on Part 1 (601	)354-6938 (fax)				
This part of the report must be completed by a licensed water well contractor or a licensed pump installer. A copy of Part 1 of the report must be attached and both parts filed with the Department at the above address within 30 days of well completion.					
Well Owner Information	Well Location				
Owner Name: Dorrell Corperter	Latitude: 34 · 53 · 748 Longitude: 89 · 44 · 970				
Mailing Address: 2249 red books rd.	Method of Lat/Long (check one): Conventional Survey,				
2	USGS quad, Hand-held GPS, Survey-grade GPS				
Byhalia Ms 38611 City State Zip Code	$\frac{NE}{4} \frac{5\omega}{4} \frac{3\omega}{8} \frac{3\omega}{4} \frac{3\omega}{8} \frac{1}{2} \frac{3\omega}{4} \frac{1}{2} \frac{3\omega}{8} \frac{1}{2} \frac{1}{$				
	Distance Direction Nearest Town				
Telephone No. (901) 489 - 7804	<u>Illa Miles SE of miller</u>				
Pump Type Circle one	Power Type Circle one				
Air Lift Jet Submersible	Diesel Engine Gasoline Engine Natural Gas				
Bucket Piston Turbine	Electric Motor Hand Tractor PTO				
Centrifugal Rotary Flowing Well	Windmill   Other (specify):				
Other (specify):	Horse Power Rating of Motor:3/4				
Date Pump Installed: <u>4-7-08</u>	Setting Depth: <u> </u>				
Rated Pump Capacity: Gallons Per Minute	Number of Stages:				
Pump Test Data	Method of Measuring Water Level				
Date Well Tested: <u> </u>	Circle one				
Static Water Level (A): 12 Feet Below Land Surface	Air Line Electric Measuring Line Steel Tape				
Pumping Water Level (B): Feet Below Land Surface	Other (specify): [neight				
Drawdown [(B) – (A)]:Feet Below Land Surface	For flowing well, measured shut in head: <u>~77</u> feet				
Test Pumping Rate: <u>( )</u> Gallons Per Minute	Well yielded GPM with a drawdown of				
Duration of Pump Test (minimum 4 hours):hours	$-$ feet after $\overline{\partial 4}$ hours of pumping				
I HEREBY CERTIFY that the above statements are true to the best of my knowledge.					

.

 I HEREBY CERTIFY that the above statements are true to the best of my knowledge.

 Image: Torse with the above statements are true to the best of my knowledge.

 Image: Torse with the above statements are true to the best of my knowledge.

 Image: Torse

MAY 0 5 2008

**BY: OLWR**