

MISSISSIPPI DEPARTMENT OF NATURAL RESOURCES

Bureau of Land and Water Resources

Southport Mall

P.O. Box 10631

Jackson, Mississippi 39209

WATER WELL DRILLERS LOG

HICKS WELL COMPANY

~~XXXXXXXXXX~~
 H 221

DeSoto

6-18 1982 RT. 1 BOX 157
 date well completed firm name

~~XXXXXXXXXX~~
 county well located

SENATORIA, MISS.

LANDOWNER: Joe Taylor

description of formations encountered

from

to

3 128 Red Bank Rd North
 Byhalia, Miss. 38611
 (mailing address)

Red Clay

0 20

Red sand

20 55

WELL LOCATION:

sec. 16 T 2 N R 5 E
 4 miles SE of Fairview
 (distance) (direction) (nearest town)

White sand & clay

55 80

White sands

80 125

WELL PURPOSE: Home
 (home, irrigation, municipal, industrial)

WELL COMPLETION DATA:

- (1) diameter (inches) 4
- (2) total depth (feet) 125
- (3) static water level (feet) 60 below top of ground.
- (4) casing PVC, 125 (material), (depth)
 4" (size) if telescope see back.
- (5) screen 7 (length), 118 (depth to top)
 02 (size), PVC + gravel (material)
- (6) pump 3/4 (HP), 10 (yield gpm)
 220V (type power)
- (7) electric log No (yes or no)

(organization running log)

(8) how well bottom plugged Cap

DEPT. OF NATURAL RESOURCES
 BUREAU OF LAND & WATER RESOURCES


JUL - 6 1982

DRILLERS REMARKS:

RECEIVED

If well telescopes please sketch and show depths.

GROUND LEVEL

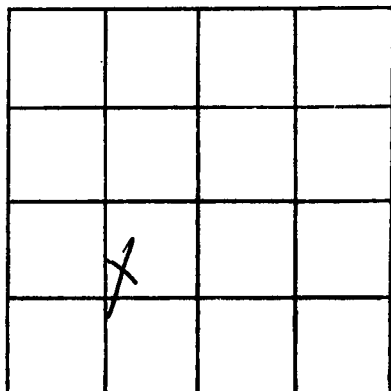

SECTION 16

Please indicate well location X.

ADDITIONAL INFORMATION

If more than one screen,
show locations of each on sketch.