

State Well Report

Part 1 - Driller's Log

Mississippi Department of Environmental Quality
Office of Land and Water Resources
P.O. Box 2309
Jackson, MS 39225
(601)961- 5210
(601)961- 5228 (fax)

For Office Use Only:

Aquifer: H 223
Well #: _____
L. S. Elevation: _____
E-log #: _____

County: DeSoto
Permit #: _____
Driller: Jones W. Mason
Date drilling completed: 6-9-11

State Law requires that this report be prepared by the license holder responsible for the work and filed with the Department at the above address within 30 days of completion of drilling of the well or borehole.

Information on Well Owner (Landowner if borehole is not for a water well)	Well or Borehole Location
Owner Name: <u>Ron Honey</u>	Latitude: <u>34° 53' 52.4"</u> Longitude: <u>89° 51' 48.6"</u>
Mailing Address: <u>7095 Allison rd.</u>	Method of Lat/Long (circle one): Conventional Survey, USGS quad, <u>Hand-held GPS</u> , Survey-grade GPS
<u>Olive Branch</u> <u>MS</u> <u>38654</u>	<u>SW 1/4 SW 1/4 Sec 20</u> Twn <u>2S</u> Rng <u>6W</u>
City State Zip Code	Distance Direction Nearest Town <u>21.8</u> Miles <u>NW</u> of <u>Lewisburg</u>
Telephone No. <u>(901) 412-1736</u>	

Well / Borehole Data

Date drilling started: 6-9-11 Date drilling completed: 6-9-11 Hole depth: 125 Hole diameter: 63/4
Location of the source of any surface water used for drilling: NA
Method of dosing and volume of Chlorine used in drilling and development: NA
Logs run (circle all applicable): No log run Electric Gamma Ray Density Sonic Neutron Other: _____
Name of organization running log(s): NA
Purpose of borehole (check one): Water Well Geotechnical/Geological Investigation Ground Source Heat Pump
Seismic Survey Other (describe) NA
If drilling is not related to water well construction, skip the remainder of this block


Purpose of Well (check one): Home Industrial Public Supply Irrigation Fish Culture Other: _____
If a flowing well, method of flow regulation: Valve Other (describe) _____
Static Water Level: 62 feet above or below (circle one) land surface Date measured: 6-9-11
Method of Measurement (circle one) steel tape electric tape air line other: string/weight
Well depth: 125 Well grouted to a depth of 50 feet Type of grout (circle one): Neat Cement Bentonite Mix
Casing length: 105 feet Casing diameter: 4 inches Type of casing: pvc
Screen length: 20 feet Screen diameter: 4 inches Type of screen: pvc
Screen slot size: .010 inches Setting depth: From 105 feet to 125 feet
Type of completion (circle all applicable): Gravel packed Underreamed Telescoped Open hole Natural Development
Other (describe): NA
Top of lap pipe or reduction in casing: NA feet. **If telescoped or more than one screen, describe on next page**

H223

The sketch below only required for water wells


Description of formations encountered must be provided for all wells and boreholes, unless specifically exempted by regulations

If well telescopes, show depths on sketch.

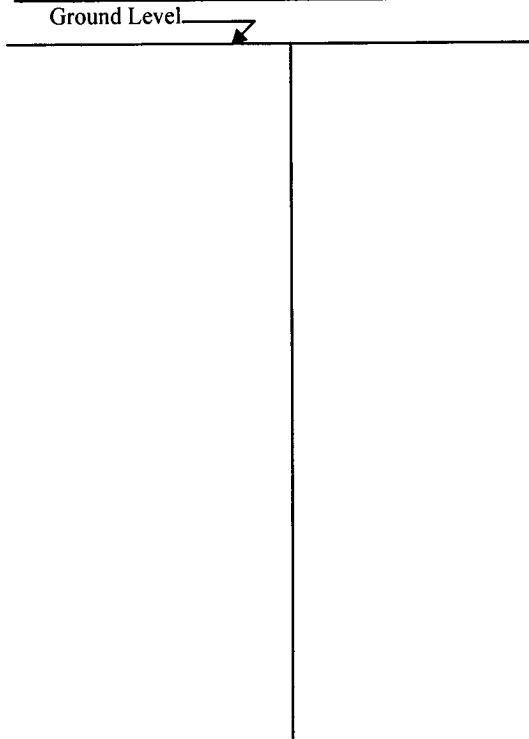

Description of Formations Encountered	From (depth)	To (depth)
clay dirt.	Ground Level	12
gravel	12	30
blue clay	30	70
white sand.	70	125

If more than one screen, show location of each on sketch

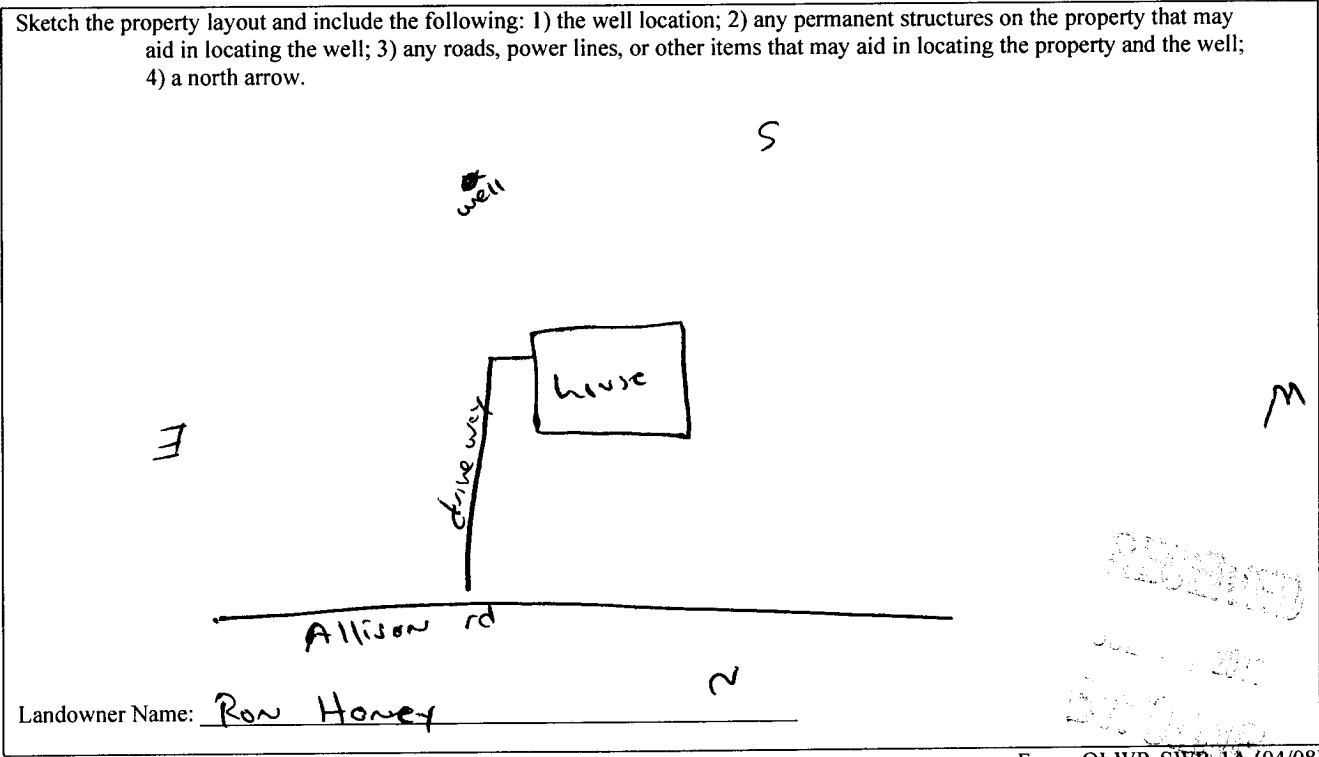

Form: OLRW-SWR-1A (04/08)

I certify that the well/borehole was drilled, constructed, and completed in accordance with all applicable requirements of the Mississippi Department of Environmental Quality and the Mississippi Department of Health regulations, if applicable, and state laws.

Jones W. Mason 0-620 7-7-11 Jones W. Mason
 Print Name of Responsible Licensee and License No. Date Signature of Licensee

STATE WELL REPORT

Part 2

Pump Installer's Completion Report
 Mississippi Department of Environmental Quality
 Office of Land and Water Resources
 P.O. Box 2309
 Jackson, MS 39225
 (601)961-5210
 (601)961-5228 (fax)

For Office Use Only:

Aquifer: _____
 Well #: _____
 Elevation: _____

County: Desoto
 Permit #: _____
 Driller: Jones W. Mason
 Date completed: 6-9-11
Copy information from block on Part 1

This part of the report must be completed by a licensed water well contractor or a licensed pump installer. A copy of Part 1 of the report must be attached and both parts filed with the Department at the above address within 30 days of well completion.

Well Owner Information	Well Location
Owner Name: <u>Ray Honey</u>	Latitude: <u>34.53.534</u> Longitude: <u>89.51.806</u>
Mailing Address: <u>7095 Allison rd.</u>	Method of Lat/Long (check one): Conventional Survey _____, USGS quad _____, Hand-held GPS <input checked="" type="checkbox"/> , Survey-grade GPS _____
<u>Olive Branch MS 38654</u> City State Zip Code	<u>S 1/4 SW 1/4 Sec 20 T 2s R 6W</u>
Telephone No. <u>(901) 412-1736</u>	Distance Direction Nearest Town <u>2 1/8 Miles NW of Lewisburg</u>

Pump Type Circle one	Power Type Circle one
Air Lift Jet <input type="checkbox"/> Submersible <input checked="" type="checkbox"/>	Diesel Engine Gasoline Engine Natural Gas
Bucket Piston Turbine	Electric Motor <input checked="" type="checkbox"/> Hand Tractor PTO
Centrifugal Rotary Flowing Well	Windmill Other (specify): _____
Other (specify): _____	Horse Power Rating of Motor: <u>1 1/2</u>
Date Pump Installed: <u>6-9-11</u>	Setting Depth: <u>90</u> feet
Rated Pump Capacity: <u>25</u> Gallons Per Minute	Number of Stages: <u>11</u>

Pump Test Data	Method of Measuring Water Level Circle one
Date Well Tested: <u>6-9-11</u>	Air Line Electric Measuring Line Steel Tape
Static Water Level (A): <u>62</u> Feet Below Land Surface	Other (specify): <u>string level</u>
Pumping Water Level (B): <u>NA</u> Feet Below Land Surface	For flowing well, measured shut in head: <u>NA</u> feet
Drawdown [(B) - (A)]: <u>NA</u> Feet Below Land Surface	Well yielded <u>25</u> GPM with a drawdown of
Test Pumping Rate: <u>25</u> Gallons Per Minute	<u>NA</u> feet after <u>24</u> hours of pumping
Duration of Pump Test (minimum 4 hours): <u>24</u> hours	

I HEREBY CERTIFY that the above statements are true to the best of my knowledge.

Jones W. Mason 0-620 Jones W. Mason
 Print Name of Pump Installer and License No. (if applicable) Signature of Pump Installer