

State Well Report

Part 1 - Driller's Log

Mississippi Department of Environmental Quality
Office of Land and Water Resources
P.O. Box 10631
Jackson, MS 39289-0631
(601)961-5210
(601)354-6938 (fax)

For Office Use Only:

Aquifer: _____
Well #: H 224
L. S. Elevation: _____
B-log #: _____

County: Desoto
Permit #: 0-163
Driller: Larry Carpenter
Date drilling completed: 3-19-12

State Law requires that this report be prepared by the license holder responsible for the work and filed with the Department at the above address within 30 days of completion of drilling of the well or borehole.

Information on Well Owner <i>(Landowner if borehole is not for a water well)</i>	Well or Borehole Location
Owner Name: <u>Bridgeforth Homes</u>	Latitude: <u>34° 58' 29"</u> Longitude: <u>89° 15' 19.5"</u>
Mailing Address: <u>3606 Bridgeforth</u>	Method of Lat/Long (circle one): <u>56 15 47 02</u> Conventional Survey
<u>Oliver Branch MS 38654</u>	USGS quad, <u>(Hand-held GPS)</u> Survey-grade GPS
City State Zip Code	<u>NW 1/4 SE 1/4 Sec 1 Twn 2S Rng R6W</u>
Telephone No. <u>(662) 895 4441</u>	Distance Direction Nearest Town <u>2</u> Miles <u>E</u> of <u>Oliver Branch</u>

Well / Borehole Data

Date drilling started: 3-17-12 Date drilling completed: 3-22-12 Hole depth: 260' Hole diameter: 8"

Location of the source of any surface water used for drilling: Well Water

Method of dosing and volume of Chlorine used in drilling and development: Yield Chlorine to 1000 Gal. Water

Logs run (circle all applicable): (No log run) Electric Gamma Ray Density Sonic Neutron Other: _____

Name of organization running log(s): _____

Purpose of borehole (check one): Water Well Geotechnical/Geological Investigation _____ Ground Source Heat Pump _____

Seismic Survey _____ Other (describe) _____

If drilling is not related to water well construction, skip the remainder of this block

Purpose of Well (check one): Home Industrial _____ Public Supply _____ Irrigation _____ Fish Culture _____ Other: _____

If a flowing well, method of flow regulation: Valve _____ Other (describe) _____

Static Water Level: 140 feet above or (below) (circle one) land surface Date measured: 3-22-12

Method of Measurement (circle one) (steel tape) electric tape air line other: _____

Well depth: 260' Well grouted to a depth of 10 feet Type of grout (circle one) (Neat Cement) Bentonite Mix

Casing length: 240 feet Casing diameter: 4 inches Type of casing: PVC

Screen length: 20 feet Screen diameter: 4 inches Type of screen: PVC

Screen slot size: .013 inches Setting depth: From 240 feet to 260 feet

Type of completion (circle all applicable): (Gravel packed) Underreamed Telescoped Open hole Natural Development

Other (describe): _____

Top of lap pipe or reduction in casing: _____ feet. *If telescoped or more than one screen, describe on next page*

Form: OLWR-SWR-1A

RECEIVED

APR 19 2012

BY: OLWR

STATE WELL REPORT

Part 2

Pump Installer's Completion Report
 Mississippi Department of Environmental Quality
 Office of Land and Water Resources
 P.O. Box 10631
 Jackson, MS 39289-0631
 (601)961-5210
 (601)354-6938 (fax)

County: Desoto
 Permit #: 0-162
 Driller: Larry Carpenter
 Date completed: 3-22-12
Copy information from block on Part 1

For Office Use Only:

Aquifer: _____
 Well #: H224
 Elevation: _____

This part of the report must be completed by a licensed water well contractor or a licensed pump installer. A copy of Part 1 of the report must be attached and both parts filed with the Department at the above address within 30 days of well completion.

Well Owner Information	Well Location
Owner Name: <u>Bridgeforth Homes</u>	Latitude: <u>34° 50.29</u> Longitude: <u>89° 15.195</u>
Mailing Address: <u>3606 Bridgeforth Rd.</u>	Method of Lat/Long (check one): Conventional Survey <input type="checkbox"/> ^{56.15} _{47.02}
<u>Olive Branch, MS 38654</u>	USGS quad _____, Hand-held GPS <input checked="" type="checkbox"/> , Survey-grade GPS _____
City State Zip Code	_____ 1/4 _____ 1/4 Sec <u>1</u> T <u>25</u> R <u>5W</u>
Telephone No. <u>(662) 895 4441</u>	Distance Direction Nearest Town
	<u>3</u> Miles <u>E</u> of <u>Olive Branch</u>

Pump Type Circle one	Power Type Circle one
Air Lift Jet <input type="checkbox"/> <u>Submersible</u>	Diesel Engine Gasoline Engine Natural Gas
Bucket Piston <input type="checkbox"/> Turbine <input type="checkbox"/>	<u>Electric Motor</u> Hand Tractor PTO
Centrifugal Rotary <input type="checkbox"/> Flowing Well <input type="checkbox"/>	Windmill Other (specify): _____
Other (specify): _____	Horse Power Rating of Motor: <u>1 1/2</u>
Date Pump Installed: <u>3-22-12</u>	Setting Depth: <u>180</u> feet
Rated Pump Capacity: <u>16</u> Gallons Per Minute	Number of Stages: <u>14</u>

Pump Test Data	Method of Measuring Water Level Circle one
Date Well Tested: <u>3-22-12</u>	Air Line Electric Measuring Line <u>Steel Tap</u>
Static Water Level (A): <u>140</u> Feet Below Land Surface	Other (specify): _____
Pumping Water Level (B): <u>146</u> Feet Below Land Surface	For flowing well, measured shut in head: _____ feet
Drawdown [(B) - (A)]: <u>6</u> Feet Below Land Surface	Well yielded <u>20</u> GPM with a drawdown of
Test Pumping Rate: <u>20</u> Gallons Per Minute	<u>6</u> feet after <u>4</u> hours of pumping
Duration of Pump Test (minimum 4 hours): <u>4</u> hours	

I HEREBY CERTIFY that the above statements are true to the best of my knowledge.

Larry Carpenter #0-162 Larry Carpenter
 Print Name of Pump Installer and License No. (if applicable) Signature of Pump Installer


RECEIVED

Form: OLWR-SWR-1 APR 19 2012

BY: OLWR

The sketch below only required for water wells

If well telescopes, show depths on sketch
Ground Level →

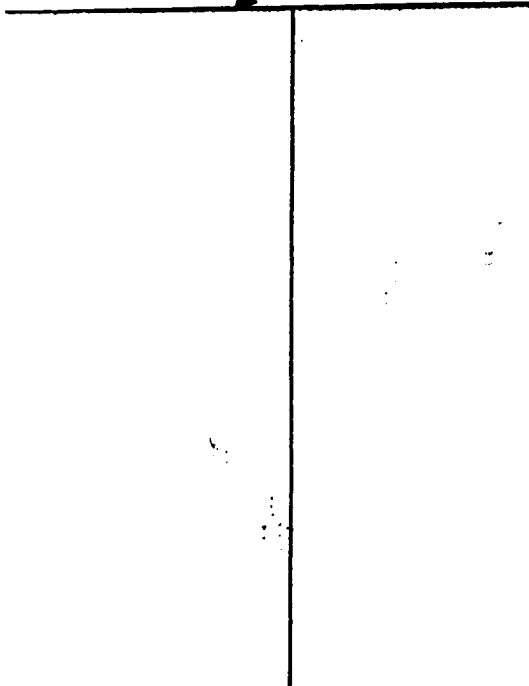


Description of formations encountered must be provided for all wells and boreholes, unless specifically exempted by regulations

Description of Formations Encountered	From (depth) Ground Level	To (depth)
Surface Soil	0	25
Clay & Gravel	25	65
White clay	65	90
Blue clay	90	150
Fine White Sand	150	215
White Coarse Sand	215	260

If more than one screen, show location of each on sketch

Sketch the property layout and include the following: 1) the well location; 2) any permanent structures on the property that may aid in locating the well; 3) any roads, power lines, or other items that may aid in locating the property and the well; 4) a north arrow.

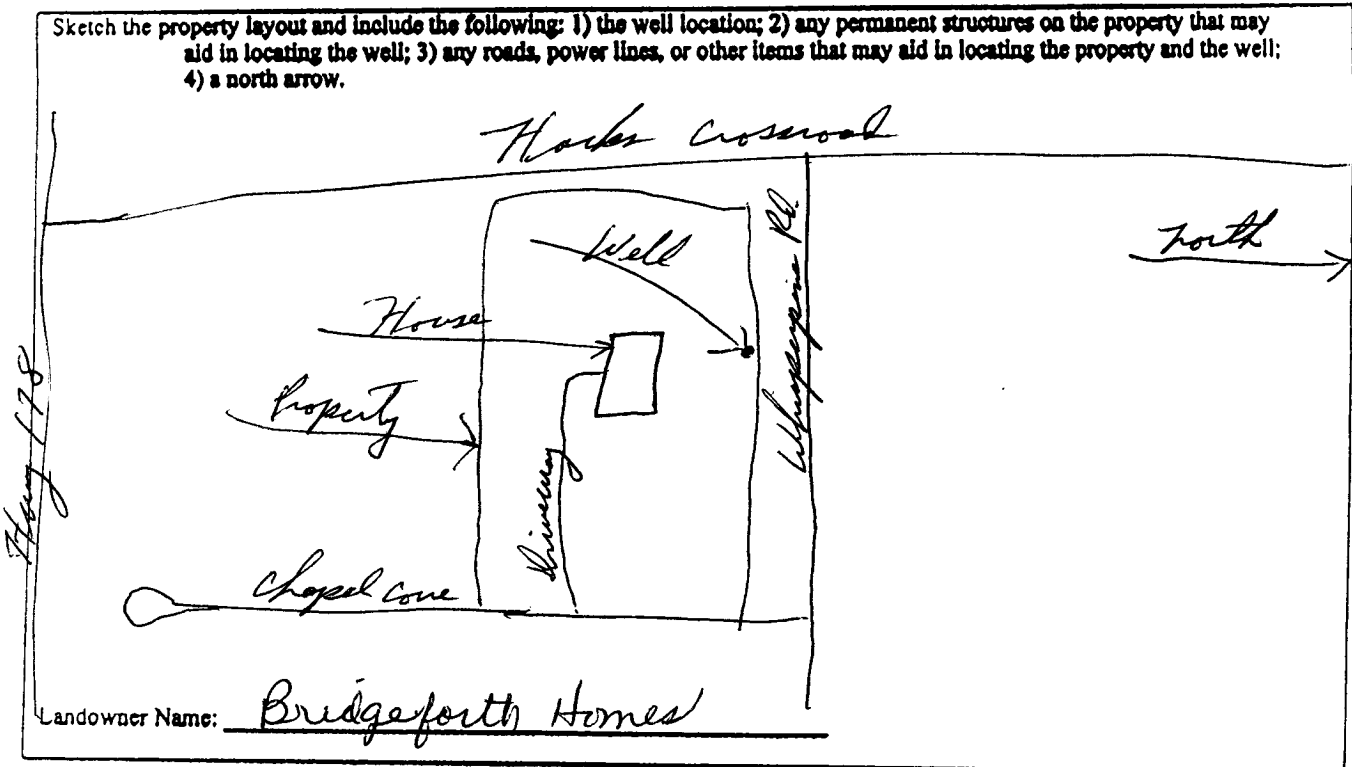

I certify that the well/borehole was drilled, constructed, and completed in accordance with all applicable requirements of the Mississippi Department of Environmental Quality and the Mississippi Department of Health regulations, if applicable, and state laws.

Larry Carpenter # 0-162 4-10-12
Print Name of Responsible Licensee and License No. Date

Larry Carpenter
Signature of Licensee

RECEIVED
APR 19 2012

BY: OLWR