	State W	All Donort		
2.1	State Well Report		For Office Use Only:	
County: Desato	Part 1 – Driller's Log Mississippi Department of Environmental Quality		A musifican	
Permit #:		nd Water Resources	Aquifer:	
		Box 2309	Well #: <u>H227</u>	
Driller: Janes w Mason		n, MS 39225	L. S. Elevation:	
Date drilling completed: 1-28-13		961- 5210	L. S. Elevation.	
	(601)96	1- 5228 (fax)	E-log #:	
State Law requires that this report Department at the above address	be prepared by the lice	ense holder responsible for t	the work and filed with the	
Information on Well O			orehole Location	
(Landowner if borehole is not for				
0 10 2		Latitude: $34 \circ 54$, 0663 , Longitude: $89 \circ 48$, 5836 ,		
Owner Name Chris Bush. Mailing Address: 9780 wccl	\	1 09	99 58 Method of Lat/Long (circle one): Conventional Survey,	
Mailing Address: 9780 Wool	w cd	Method of LavLong (circle of	- Conventional Survey,	
Walling Addiess.	34 / 61.	USGS quad, Hand-held	GPS Survey-grade GPS	
			Twn 25 Rng 6w	
Olive Brough MI	38654	NE 4 NE 4 Sec 33	Twn d > Rng 600	
City State	e Zip Code		Nearest Town	
Telephone No. (662) 890 - 606	~ I	274 Miles _ 3E	of <u>(edorview</u>	
Telephone No.				
	Well / Bore	hole Data		
Date drilling started: 1-38-13 Date dril	ling completed: 1-3.8-	13 Hole depth: 170 '	Hole diameter: 6314	
Location of the source of any surface water	used for drilling: AA			
Method of dosing and volume of Chlorine	used in drilling and devel	opment: W		
Logs run (circle all applicable): No log run Name of organization running log(s):		Density Sonic Neutron	Other:	
Purpose of borehole (check one): Water We	ll Geotechnical/Geol	ogical Investigation Ground	Source Heat Pump	
0-11-0	umiou Other (describe)	,		
Seismic S If drilling is not related to	urveyOther (describe)) n, skip the remainder of this blo	ock	
Purpose of Well (check one): Home // In	dustrial Public Supply	Irrigation Fish Culture	Other:	
If a flowing well, method of flow regulation: Valve Other (describe)				
Static Water Level: 104 feet above of below circle one) land surface Date measured: 1-25-13				
Method of Measurement (circle one) steel tape electric tape air line other: string lowight				
Well depth: 170 Well grouted to a depth of 10 feet Type of grout (circle one): Neat Cement Bentonite Mix				
Casing length: 156 feet Casing diameter: 4 inches Type of casing: 000				
Screen length:				
Screen slot size: .010 inches Setting depth: From 150 feet to 120 feet				
Type of completion (circle all applicable). Gravel packed Underreamed Telescoped Open hole Natural Development				

Top of lap pipe or reduction in casing:

feet. If telescoped or more than one screen, describe on next page

Form: OLWR-SWR-1A (04/08)

RECEIVED

FEB 2 5 2013

BY: OLWR


The sketch below only required for water wells

If	well	telescopes,	show	depths	on	sketch.
	Gro	und Level.		7		

Description of formations encountered must be provided for all wells and boreholes, unless specifically exempted by regulations

Description of Formations Encountered	From (depth)	To (depth)
clay dist	Ground Level	10
jed sad	10	30
gravel	35	55
Ble clay	22	12.5
while sound	135	סכו
	· · · · · · · · · · · · · · · · · · ·	1
	-	
	+	+
		+
	 	+
	+	
		+
	 	
	1	

If more than one screen, show location of each on sketch

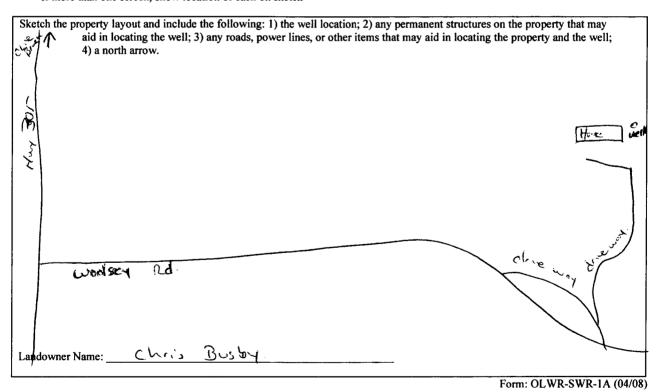

I certify that the well/borehole was drilled, constructed, and completed in accordance with all applicable requirements of the Mississippi Department of Environmental Quality and the Mississippi Department of Health regulations, if applicable, and state

Jans w. Mason 0-620	2-22-13	Jes w. Man	RECEIVED
Print Name of Responsible Licensee and License No	Date	Signature of Licensee	FFR 2 5 2013

BY: OLWR

STATE WELL REPORT					
Permit #: Driller: Tanks w. Moscar Date completed: 1-28-13 Copy information from block on Part 1	Part 2 Pump Installer's Completion Report Mississippi Department of Environmental Quality Office of Land and Water Resources P.O. Box 2309 Jackson, MS 39225 (601)961-5210 (601)961-5228 (fax)		For Office Use Only: Aquifer: Well #: H 227 Elevation:		
This part of the report must be completed by a licensed water well contractor or a licensed pump installer. A copy of Part 1 of the					
report must be attached and both parts file Well Owner Informat		t the above address within 30 days of well completion. Well Location			
Owner Name: Chris Busby		Latitude: 34,54.08.62 Longitude: 89.48,58.36			
•	Mailing Address: 9780 woolsy rd		Method of Lat/Long (check one): Conventional Survey,		
			GPS, Survey-grade GPS		
Oive Brown Ms 38654 City State Zip Code		NE 4 NE 4 Sec 22 T 25 R 6W Distance Direction Nearest Town			
Telephone No. (662) 890 - 6061		3/4 Miles <u>SE</u> of	redorview		
Pump Type Circle one			ver Type rele one		
Air Lift Jet	Submersible	Diesel Engine Gasoline	e Engine Natural Gas		
Bucket Piston	Turbine	Electric Motor Hand	Tractor PTO		
Centrifugal Rotary	Flowing Well	Windmill Other (s	pecify):		
Other (specify):	<u> </u>	Horse Power Rating of Motor:	11/2		
Date Pump Installed: 1- 2-8-13		Setting Depth: しょじ	feet		
Rated Pump Capacity:	Gallons Per Minute	Number of Stages:			
Pump Test Data		Method of Mea	suring Water Level		
Date Well Tested: 1-78-13			rcle one		
Static Water Level (A): 104 Feet	Below Land Surface	Air Line Electric Meas			
Pumping Water Level (B): \sim^A Feet F		Other (specify): 51000	weight		
Drawdown [(B) – (A)]: Feet I		For flowing well, measured shu	it in head:feet		
0 -	Gallons Per Minute	Well yielded <u> </u>	_GPM with a drawdown of		
Duration of Pump Test (minimum 4 hours):	a H hours	feet after	hours of pumping		
I HEREBY CERTIFY that the above statements are true to the best of my knowledge.					

Town Welch Or 620

Print Name of Pump Installer and License No. (if applicable)

Signature of Pump Installer
Form: OLWR-SWR-1B (04708)
FEB 2 5 2013