	STATE	WELL REPORT	307
County: Desoto	SIAIE	Part 1	For Office Use Only:
Dormit #		riller's Log	Well #: <u>H249</u>
Driller: Joes w. Mar		ment of Environmental Quality nd and Water Resources	Aquifer:
Date drilling completed: $9-8-18$		P.O. Box 2309 on, MS 39225-2309	E-Log #:
	(601)961-5210	
		1)360-0535 (fax)	
State Law requires that this report be Department at the above address with			
Well Owner Information	n		hole Location
(Landowner if borehole is not for a		Latitude: 34 54 35.69 2	ngitude: <u>89°51'54.51''w</u>
Owner Name: Fort Voncle		Method of Lat/Long (check one): Conventional Survey,
Mailing Address: 3230 C (or	rt id		
			PS., Survey-grade GPS 17R
City Branch MS	38654	<u>Nos 14 500 14, Sec</u>	17 T ΔS R 6 ω
City State	Zip Code	Miles NW o	
Telephone No. (901) 409-8005		(Distance) (Direction)	(Nearest Town)
	Well / B	orehole Data	
Date drilling started: $9 - 5 - 16$ Date d	rilling completed:	9-8-18 Hole depth: 110	Hole diameter: <u>2</u>
Location of the source of any surface was			
Method of dosing and volume of Chlorine	used in drilling a	nd development: 50 ppm	and greater
Logs run (circle all applicable): No log run			
Name of organization running log(s):			
Purpose of borehole (circle one): Water W		cal/Geological Investigation	Ground Source Heat Pump
Seismic		(describe)	
		onstruction, skip the remainder	
Purpose of Well (circle all applicable)	~		Fish Culture
Other (describe):N	industriat	Fublic Supply Intgation	
If a flowing well, method of flow regulat	ion: Valve	1A Other (describe)	BYON
		and surface Date measured	
Method of measurement (circle one): Ste			
Well depth: 110° Well grouted to a d			
Casing length: <u> 100</u> feet Casi	ing diameter:	inches Type of a	casing: $\rho \sim C$
Casing length: <u>100</u> feet Casi Screen length: <u>10</u> feet Scr	een diameter:	inches Type of	screen: <u>puc</u>
Screen slot size:	Setting depth	From 100 feet to	et lo feet
Type of completion (circle all applicable)	: Gravel packed	nderreamed Open hole	Natural Development
Other (describe): 🗾 🔁 🕌			
Top of lap pipe or reduction in casing:	م لکرfeet		
If telescop	ed or more than	one screen, describe on next pa	ge

County:
Permit #:

If well telescopes, show depths on sketch.

Ground Level


For	Office	Use	Only:
-----	--------	-----	--------------

The sketch below only required for water wells

Description of formations encountered must be provided for all wells and boreholes, unless specifically exempted by regulations

Description of Formations Encountered	From (depth)	To (depth)
clay dist	Ground level	ls
	15	65
while clay	65	110

If more than one screen, show location of each on sketch

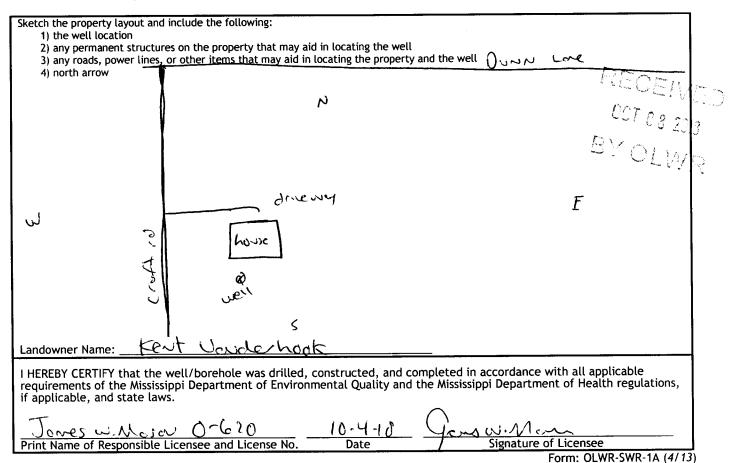

	STATE W	ELL REPORT		
County: Descto		Part 2	For Office Use Only:	
Permit #:	Pump Installer's Completion Report		Well #:	
Driller: Jaces as Mason		nent of Environmental Quality nd and Water Resources	Well #:	
Date completed: $\underline{\gamma} - \underline{\beta} - 1 \underline{\delta}$.O. Box 2309 on, MS 39225-2309	Aquifer:	
Copy information from block on Part 1		501)961-5210		
	(601) 360-0535 (fax)		
This part of the report must be complete				
of the report must be attached and both Well Owner Informati		· · · · · · · · · · · · · · · · · · ·	ocation	
Owner Name: Kent Vande	hoot	Latitude: 34°54'25,69"Lon	gitude: 89'571'54.51''w	
Mailing Address: 3730 cr		Method of Lat/Long (check one)		
		USGS quad, Hand-held GI	PS, Survey-grade GPS	
Clive Brouch Ms City State	38654	NUNSW SW 14, Sec_	17 JS RGW	
		Distance) (Direction) of (Nearest Town)		
Telephone No. (<u>901</u>) <u>409 - 80</u>	0	(Distance) (Direction)	(Nearest Town)	
	Pump Ty	pe (circle one)		
Submersible Turbine Air Lift Centrif	ugal Flowing Well	Jet Piston Rotary Other (de	scribe):	
Date Pump Installed: $9 - 8 - 18$	F	Rated Pump Capacity:10	Gallons Per Minute	
Is This Pump (circle one): (New) Rep				
	-	pe (circle one)		
Electric Diesel Gasoline Natural Gas			0	
Horse Power Rating of Motor:3/4	Setting Dept	h: <u>88</u> feet Number	of Stages:	
		for Non Flowing Well		
Date Well Tested: <u>9-8-18</u>		Duration of Pump Test (minim	um 4 hours): <u>24</u> hours	
Static Water Level (A): 65 Fee	t Below Land Surface	Pumping Water Level (B):	SIA Feet Below Land Surface	
Drawdown [(B) - (A)]:	Feet Below Land Suri	face Test Pumping Rate:	Gallons Per Minute	
Method of measurement (circle one): S	eel tape Electric ta	ape Air line Other (describe):	String Ineight	
(14	•	ta for Flowing Well		1000
Measured shut in head: $\underline{\mathcal{A}}$ feet			s and a second s	V. Period for
Well yielded <u>I</u> O GPM with a O	Irawdown of	A feet after 31	hours of pumping	
		Installation	e voi	1.09
Meter Manufacturer: ノ い		Meter Serial Number:	NN	•
Meter Model Number/Name:	4	Type of Meter:	NIA	
Totalizer Register Unit and Multiplier F	actor (AF x .001, gal	ل x 1000, etc): ل ا	Α	
Installation Date: الم	Meter installed by:	NIA		
Is This Meter (circle one): New Re	paired Replaceme	ent		
Important: By submitting the above in For agricultu	formation you are corral wells, a list of ap	ertifying that this meter was insta proved meters is on the MDEQ w	lled to manufacturer standards. ebsite.	
I HEREBY CERTIFY that the above state	ments are true to th	e best of my knowledge.		
<u>کی سرد Mesor</u> O-G Print Name of Pump Installer and Licen	73	10-4-18 CP- 1		
Print Name of Pump Installer and Licen	se No (if applicable	Date Signa	ture of Pump Installer	