


DESOTO MISSISSIPPI BOARD OF WATER COMMISSIONERS

H 2001
5-22-65

WATER WELL DRILLERS LOG

Date: May 22, 1965, Driller: K. W. Miller County Desoto
(Name)

(1) Owner of Land:	Description & Color of Materials Sand, Clay, Red Clay, Shell, etc.	Thick- ness Feet	Depth Feet
Mrs. D. B. Bridgforth (Name)	0 - 15 Surface Clay		15
Rt. #1, Nesbit, Miss. (Address)	15 - 75 Sand & Gravel		60
(2) Location: <u>26</u> $\frac{1}{4}$, <u>T</u> $\frac{1}{4}$, Sec. <u>R</u>	75 - 85 Yellow Clay		10
Pleasant	85 - 168 Blue Clay		83
<u>3</u> miles <u>N.E.</u> , of <u>Hill</u> (distance) (direction) (Nearest Town)	168 - 178 Coarse & med. Coarse Sand		10
(3) Topography: <u>Hilly</u> (Hilly) (Flat) (Level)			
(4) Purpose of Well: <u>Domestic</u> (Domestic Irrigation Municipal, Industrial, Other)			
Information upon completion of well:			
(1) Diameter <u>3</u> inches.			
(2) Total Depth <u>178</u> feet.			
(3) Water Level <u>125</u> feet below top of ground.			
(4) Cased to <u>171</u> , Size <u>3"</u>			
(5) Screen: Size <u>2"</u> , Length <u>7'</u>			
(6) Were any formations sealed against pollution?			
<u>NO</u> yes, <u>NO</u> no.			
If YES depth of formation _____			
Why _____			
Drillers Remarks: _____			

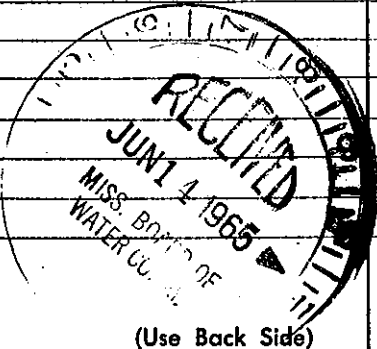

(Use Back Side)

Well No.

Mail this copy to Board of Water Commissioners 429 Miss. St. Jackson, Miss.