

Desoto
J

MISSISSIPPI BOARD OF WATER COMMISSIONERS

4-12-66

WATER WELL DRILLERS LOG

Date: 4-12, 1966, Driller: J B Blair County Panola
(Name)

(1) Owner of Land	Description & Color of Materials Sand, Clay, Red Clay, Shell, etc.	Thick- ness Feet	Depth Feet
<u>US Army Camp</u> (Name) <u>Pepperhollow Lake</u> (Address)	<u>Brown Clay</u>	<u>0</u>	<u>30</u>
	<u>Gravel + Sand</u>	<u>30</u>	<u>65</u>
(2) Location: <u>3</u> miles <u>N</u> , of <u>Pepperhollow</u> (distance) (direction) (Nearest Town)			
(3) Topography: <input checked="" type="checkbox"/> (Hilly) <input type="checkbox"/> (Flat) <input type="checkbox"/> (Level)			
(4) Purpose of Well: <u>Picnic Area</u> (Domestic Irrigation Municipal, Industrial, Other)			


Information upon completion of well:

- (1) Diameter 2 inches.
- (2) Total Depth 65 FT feet.
- (3) Water Level 40 feet below top of ground.
- (4) Cased to 65, Size 2"
- (5) Screen: Size 1/4 Length 5 FT
Hand Pump
- (6) Were any formations sealed against pollution?
_____ yes, _____ no.

If YES depth of formation _____

Why _____

Drillers Remarks: _____

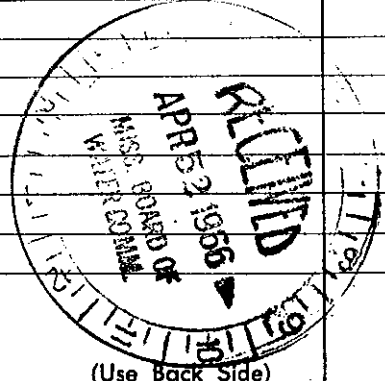

(Use Back Side)

Well No.