

Desoto

MISSISSIPPI BOARD OF WATER COMMISSIONERS

J

4-13-66

WATER WELL DRILLERS LOG

Date: 4-13, 1966, Driller: J B Cain County: Parale

(Name)

(1) Owner of Land:	Description & Color of Materials	Thick- ness Feet	Depth Feet
US Army Corp (Name)	Sand, Clay, Red Clay, Shell, etc.		
Oriskany Lake (Address)	<del>Clay</del> Clay	0	28
	Gravel	28	50
	Sand	50	68
(2) Location: 1/4, 1/4, Sec. T R			
3 miles N of Oriskany (distance) (direction) (Nearest Town)			
(3) Topography: <input checked="" type="checkbox"/> Hilly <input type="checkbox"/> Flat <input type="checkbox"/> Level			
(4) Purpose of Well: <u>Public Area</u> (Domestic, Irrigation, Municipal, Industrial, Other)			


Information upon completion of well:

- (1) Diameter 2 inches.
- (2) Total Depth 68 feet.
- (3) Water Level 42 feet below top of ground.
- (4) Cased to 68, Size 2"
- (5) Screen Size 1 1/4, Length 5 FT  
Stainless Steel
- (6) Were any formations sealed against pollution?  
\_\_\_\_\_ yes, \_\_\_\_\_ no.

If YES depth of formation \_\_\_\_\_

Why \_\_\_\_\_

Drillers Remarks: \_\_\_\_\_

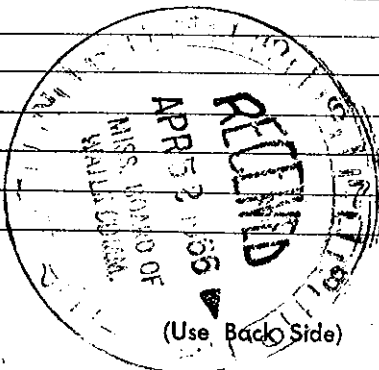

Well No.

Retain this copy for your office files.