

Desoto

MISSISSIPPI BOARD OF WATER COMMISSIONERS

J3

2-25-63

WATER WELL DRILLERS LOG

CODED 3

Date: 2-25-63, 19___, Driller: Layne-Central Co. County Desoto

(Name)

Boy Scouts of America

(1) Owner of Land: Camp Carrier

(Name)

Eudora, Mississippi

(Address)

(2) Location: 1/4, 1/4, Sec. T R

miles of (distance) (direction) (Nearest Town)

(3) Topography: (Hilly) (Flat) (Level)

(4) Purpose of Well: Boy Scout Camp

(Domestic Irrigation Municipal, Industrial, Other)

Description & Color of Materials Sand, Clay, Red Clay, Shell, etc.	Thick- ness Feet	Depth Feet
clay	0	42
sand and gravel	42	95
rock	95	96
sandy clay	96	170
clay and sand st.	170	272
fine sand and clay st.	272	295
sand	295	309
tough clay	309	336
sand	336	363
clay	363	370
sand	370	412
clay	412	415

Information upon completion of well:

(1) Diameter 8" inches.

(2) Total Depth 416' feet.

(3) Water Level 108' feet below top of ground.

(4) Cased to 371', Size 8"

(5) Screen: Size 6", Length 40' 10"

(6) Were any formations sealed against pollution?

x yes, no.


If YES depth of formation 371'

Why required

Drillers Remarks:

CODED

Handwritten signature/initials

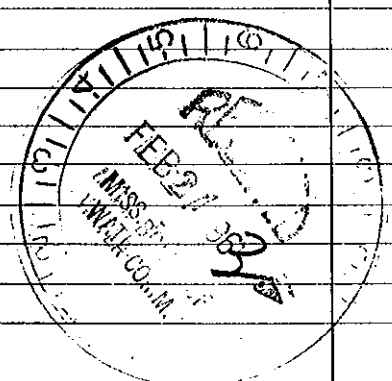

(Use Back Side)

Well No.

Retain this copy for your office files.