

Desoto MISSISSIPPI BOARD OF WATER COMMISSIONERS

J 36
8-8-60

WATER WELL DRILLERS LOG **CODED**

Date: 8-8, 1960, Driller: A.C. Henderson County Desoto
(Name)

(1) Owner of Land: J.W. Cantor
(Name)
Route one Harrison
(Address)

(2) Location: 1/4, 1/4, Sec. 19 T3R9
1 1/2 miles SW of Harrison
(distance) (direction) (Nearest Town)

(3) Topography: Flat
(Hilly) (Flat) (Level)

(4) Purpose of Well: home
(Domestic Irrigation
Municipal, Industrial, Other)

Description & Color of Materials Sand, Clay, Red Clay, Shell, etc.	Thick- ness Feet	Depth Feet
<u>Red clay 70</u>	<u>70</u>	<u>96</u>
<u>white sand</u>	<u>26</u>	
<u>small gravel</u>		

CODED

#0052

Information upon completion of well:

(1) Diameter 2 inches.

(2) Total Depth 96 feet.


(3) Water Level 60' feet below top of ground.

(4) Cased to 96', Size 2"

(5) Screen: Size 1/4, Length 6'

(6) Were any formations sealed against pollution?
_____ yes, _____ no.

If YES depth of formation _____
Why _____
Drillers Remarks: _____

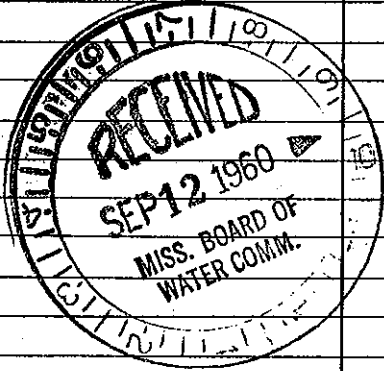

Well No. 5

(Use Back Side)

Mail this copy to Board of Water Commissioners 429 Miss. St. Jackson, Miss.