

Desoto MISSISSIPPI BOARD OF WATER COMMISSIONERS

J 37
9-21-60

WATER WELL DRILLERS LOG

CODED

Date: 9-21, 1960, Driller: A.C. Henderson, County Desoto
(Name)

(1) Owner of Land: <u>J.A. Henderson</u> (Name)	Description & Color of Materials Sand, Clay, Red Clay, Shell, etc.	Thick- ness Feet	Depth Feet
<u>Route Henderson</u> (Address)	<u>60' Red clay</u>	<u>60'</u>	
(2) Location: <u>1/4, S 1/4, Sec 10, 15, 21, 3R 9,</u> <u>9 miles EW</u> of <u>Hanna, Mo.</u> (distance) (direction) (Nearest Town)	<u>mixed sand & rocks (small)</u>	<u>28'</u>	<u>88</u>
(3) Topography: <u>X</u> (Hilly) (Flat) (Level)			
(4) Purpose of Well: (Domestic Irrigation Municipal, Industrial, Other)			

Information upon completion of well:


- (1) Diameter 4 inches.
- (2) Total Depth 88 feet.
- (3) Water Level 68 feet below top of ground.
- (4) Cased to 88, Size 4"
- (5) Screen: Size 4", Length 10'
All-Plastic
- (6) Were any formations sealed against pollution?
_____ yes, _____ no.

If YES depth of formation _____

Why _____

Drillers Remarks: _____

CODED

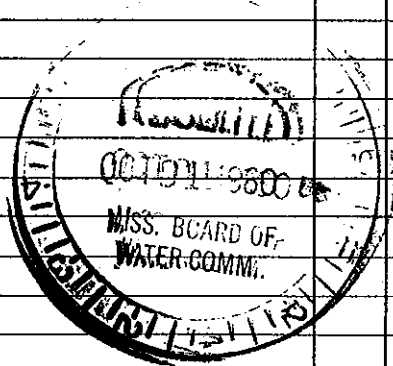

9

Well No.

(Use Back Side)

Mail this copy to Board of Water Commissioners 429 Miss. St. Jackson, Miss.