

Desoto

Date: 3-10, 1961, Driller: H. Henderson, Desoto

J 38

(Name)

**CODED**


(1) Owner of Land	Description & Color of Materials Sand, Clay, Red Clay, Shell, etc.	Thick- ness Feet	Depth Feet
3-10-61 W. L. Smith (Name) Woodland Lake (Address)	40' Red clay 9' fine gravel & sand		49'
(2) Location: 1/4, 1/4, Sec. 18 T. 3R. 9.			
10 miles W of Hernando (distance) (direction) (Nearest Town)			
(3) Topography: Hilly (Flat) (Level)			
(4) Purpose of Well: Home (Domestic Irrigation Municipal, Industrial, Other)			

0057

Information upon completion of well:

- (1) Diameter 2' inches.
- (2) Total Depth 49' feet.
- (3) Water Level 33' feet below top of ground.
- (4) Cased to 43', Size 2"
- (5) Screen: Size 1/4", Length 6'
- (6) Were any formations sealed against pollution?  
\_\_\_\_\_ yes, \_\_\_\_\_ no.

**CODED**

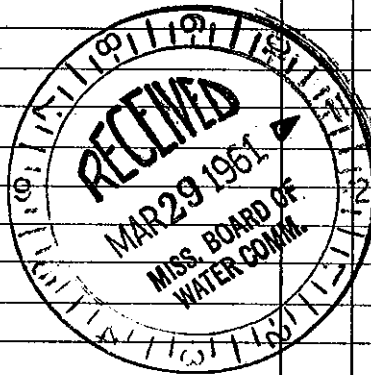

If YES depth of formation \_\_\_\_\_

Why \_\_\_\_\_

Drillers Remarks: \_\_\_\_\_

17

Well No.

(Use Back Side)

Retain this copy for your office files.