

WELL DRILLERS LOG


Date: 3-27, 1961, Driller: Desoto **CODED** Desoto  
J 39  
 (Name)

| (1) Owner of Land:   | Description & Color of Materials<br>Sand, Clay, Red Clay, Shell, etc. | Thick-<br>ness<br>Feet | Depth<br>Feet |
|--|---|------------------------|---------------|
| <u>J.B. Fickett</u><br>(Name)<br><u>Woodland Lake</u><br>(Address)   | <u>Red clay</u>   | <u>60</u>              | <u>247</u>    |
| (2) Location: <u>1/4</u> , <u>1/4</u> , Sec. <u>18 T3 R9</u> ,<br><u>10</u> miles <u>W</u> of <u>Herdon</u><br>(distance) (direction) (Nearest Town) | <u>sand + streak</u><br><u>of clay</u><br><u>fine black sand</u>      | <u>187</u>             |               |
| (3) Topography: <u>X</u><br>(Hilly) (Flat) (Level)   | <b>CODED</b>  |                        |               |
| (4) Purpose of Well:<br>(Domestic Irrigation, Municipal, Industrial, Other)  | <u>#0052</u>  |                        |               |

Information upon completion of well:

- (1) Diameter 4" inches.
- (2) Total Depth 247 feet.
- (3) Water Level 60' feet below top of ground.
- (4) Cased to 230', Size 9 1/4" 13 1/2" 2 1/2"
- (5) Screen: Size 1 1/2", Length 14'
- (6) Were any formations sealed against pollution?  
 yes,  no.

If YES depth of formation \_\_\_\_\_  
 Why \_\_\_\_\_  
 Drillers Remarks: \_\_\_\_\_

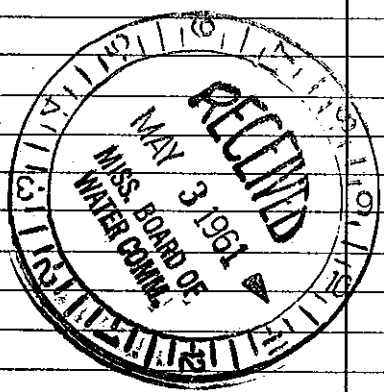

19

Well No.

(Use Back Side)

Retain this copy for your office files.