

Des. J 41

WATER WELL DRILLING

Date: 4-16-61, 1961, Driller: A.C. Henderson
Scheeper (Name)

(1) Owner of Land: Jack Scheibler
(Name)
Woodland Lake
PT 1 Harbando miss

(2) Location: 1/4, 1/4, Sec. 20 T5R9,
11 miles west of Harbando,
(distance) (direction) (Nearest Town)

(3) Topography: X
(Hilly) (Flat) (Level)

(4) Purpose of Well: Home use
(Domestic Irrigation
Municipal, Industrial, Other)

Description & Color of Materials Sand, Clay, Red Clay, Shell, etc.	Feet
<u>53' Red clay</u>	<u>53</u>
<u>24' Sand & gravel</u>	<u>24</u>

CODED

lot 149
#0052

CODED

Information upon completion of well:

(1) Diameter 2" inches.

(2) Total Depth 77' feet.

(3) Water Level 36 feet below top of ground.

(4) Cased to 71', Size 2"


(5) Screen: Size 1/4, Length 6'

(6) Were any formations sealed against pollution?
_____ yes, _____ no.

If YES depth of formation _____

Why _____

Drillers Remarks: _____

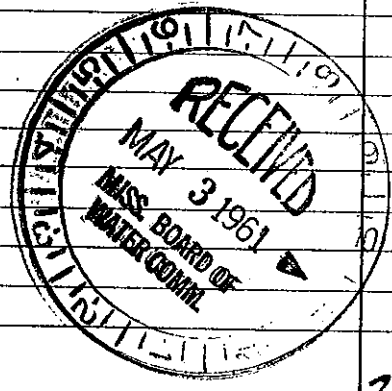

23 Well No.

(Use Back Side)

Retain this copy for your office files.