

Desoto WATER WELL DRILLERS LOG

J 42
 Date: 5-26-61 1961, Driller: A.C. Henderson [?] Desoto
 (Name)

CODED

(1) Owner of Land: <u>S. Daniel</u> (Name) <u>RT 1 Hernando</u> (Address)	Description & Color of Materials Sand, Clay, Red Clay, Shell, etc. 60' Red sand	Thick- ness Feet	Depth Feet
(2) Location: <u>1/4, 1/4, Sec. 29 T3R9,</u> <u>9 miles W</u> of <u>Hernando</u> (distance) (direction) (Nearest Town)	<u>Red clay</u> <u>Red sand</u> <u>Sand & gravel</u> <u>white sand</u>	<u>60'</u> <u>6'</u> <u>10'</u> <u>16'</u>	<u>92'</u>
(3) Topography: <u>X</u> (Hilly) (Flat) (Level)			
(4) Purpose of Well: <u>house</u> (Domestic Irrigation Municipal, Industrial, Other)			


Information upon completion of well:

- (1) Diameter 2 inches.
- (2) Total Depth 92' feet.
- (3) Water Level 10' feet below top of ground.
- (4) Cased to 87', Size 2"
- (5) Screen: Size 1/4", Length 5'
- (6) Were any formations sealed against pollution?
 _____ yes, _____ no.

If YES depth of formation _____
 Why _____
 Drillers Remarks: _____

CODED

0052

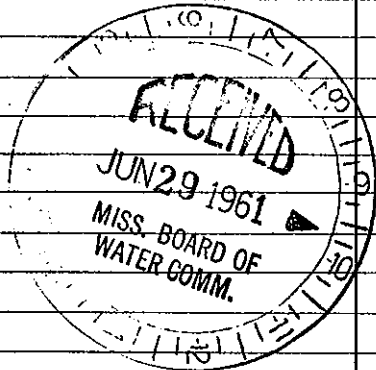

26
 Well No.

(Use Back Side)