

Desoto

J 45

4-22-62

Date: 4-22

WATER WELL DRILLERS LOG

Driller: H H Well Co. Desoto

CODED

(Name)

(1) Owner of Land:	Description & Color of Materials Sand, Clay, Red Clay, Shell, etc.	Thick- ness Feet	Depth Feet
R. F. D. Nestle	Red clay	60'	82
2 miles West	Sand	22	
Herrondo 2 mi, North			
(2) Location: 1/4, 1/4, Sec. 40-39			
miles, of			
(3) Topography: <input checked="" type="checkbox"/> (Hilly) <input type="checkbox"/> (Flat) <input type="checkbox"/> (Level)			
(4) Purpose of Well: (Domestic Irrigation, Municipal, Industrial, Other)			

CODED

Information upon completion of well:


- (1) Diameter 2" inches.
- (2) Total Depth 82 feet.
- (3) Water Level 60' feet below top of ground.
- (4) Cased to 77', Size 2"
- (5) Screen: Size 1/4", Length 6'
- (6) Were any formations sealed against pollution?
_____ yes, _____ no.

Rob Pump

If YES depth of formation _____

Why _____

Drillers Remarks: _____

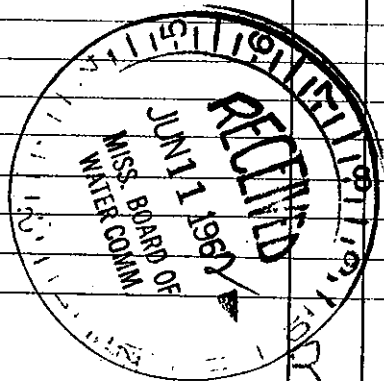

Well No.

(Use Back Side)

Retain this copy for your office files.