

COMMISSIONERS

Desoto

J Al

4-25-62

Date:

WATER WELL DRILLER

CODED

17 + N Well Co

Desoto

(Name)

(1) Owner of Land: A J Dockery

(Name)

RFD, Hammond

(Address)

Description & Color of Materials
Sand, Clay, Red Clay, Shell, etc.

Thick-
ness
Feet

Depth
Feet

Red Clay

45' 10"

streak Sand + clay

25'

(2) Location: 1/4, 1/4, Sec. 28 T3R9

9 W Hammond

5 mi S of Eudora

(3) Topography: None

(Hilly) (Flat) (Level)

(4) Purpose of Well: None

(Domestic Irrigation
Municipal, Industrial, Other)

CODED

Information upon completion of well:

(1) Diameter 2" inches.


(2) Total Depth 70' feet.

(3) Water Level 35' feet below top of ground.

(4) Cased to 64', Size 2"

(5) Screen: Size 1/4", Length 6'

Root Pump

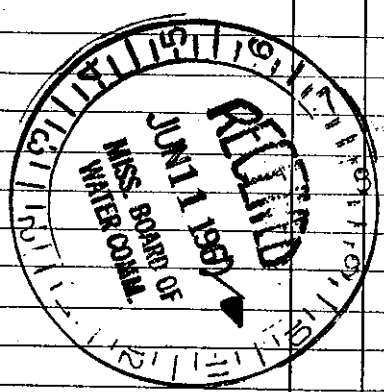

(6) Were any formations sealed against pollution?

yes, no.

If YES depth of formation _____

Why _____

Drillers Remarks: _____

9

Well No.

(Use Back Side)

Retain this copy for your office files.