

Desoto  
JA7

### WATER WELL DRILLERS LOG

Date: 5-6-62, 192, Driller: H. H. Hill & Co. Desoto

A.C. Henderson (Name)

**CODED**


(1) Owner of Land:	Description & Color of Materials Sand, Clay, Red Clay, Shell, etc.	Thick- ness Feet	Depth Feet
<u>Samuel Jones</u> (Name)	<u>Red clay</u>	<u>84</u>	<u>144</u>
<u>R.P. Henderson</u> (Address)	<u>gravel</u>	<u>10</u>	
<u>17 26</u>	<u>hard Rocks</u>	<u>12</u>	
(2) Location: <u>1/4</u> , <u>1/4</u> , Sec. <u>30 T. 39</u>	<u>blue clay</u>	<u>20</u>	
<u>15</u> miles <u>west</u> <u>Henderson</u>	<u>White Sand (concrete)</u>	<u>18</u>	
(distance) (direction) (Nearest Town)			
(3) Topography: <u>Hilly</u>			
(Hilly) (Flat) (Level)			
(4) Purpose of Well: <u>Domestic Irrigation</u>			
(Municipal, Industrial, Other)			

**CODED**

Information upon completion of well:

- (1) Diameter 2 inches.
- (2) Total Depth 44 feet.
- (3) Water Level 19 feet below top of ground.
- (4) Cased to 138, Size 2"
- (5) Screen: Size 1/8, Length 6'
- (6) Were any formations sealed against pollution?  
\_\_\_\_\_ yes, \_\_\_\_\_ no.

Rob Pump

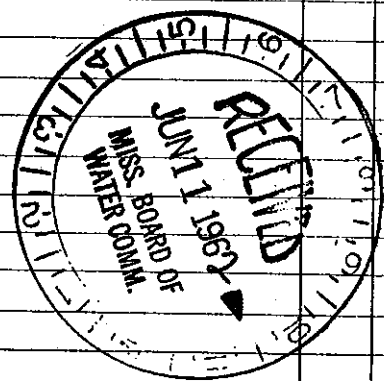

If YES depth of formation \_\_\_\_\_

Why \_\_\_\_\_

Drillers Remarks: \_\_\_\_\_

14

Well No.

Retain this copy for your office files.

(Use Back Side)