

DE SOTO MISSISSIPPI BOARD OF WATER COMMISSIONERS

JAS

12-22-65

WATER WELL DRILLERS LOG

CODED

Date: Dec 22, 19 65, Driller: Shelly Neyman County De Soto

(Name)

(1) Owner of Land:	Description & Color of Materials Sand, Clay, Red Clay, Shell, etc.	Thick- ness Feet	Depth Feet
<u>Hercules Bowler</u> (Name) <u>Hernando Miss</u> (Address)	<u>Red clay</u>	<u>60</u>	
(2) Location: <u>1/4</u> , <u>1/4</u> , Sec. <u>30 T3 R9</u> , <u>4</u> miles <u>W</u> of <u>Endora</u> (distance) (direction) (Nearest Town)	<u>White clay</u>	<u>20</u>	
(3) Topography: <input checked="" type="checkbox"/> (Hilly) <input type="checkbox"/> (Flat) <input type="checkbox"/> (Level)	<u>Sand & gravel</u>	<u>80</u>	
(4) Purpose of Well: <input checked="" type="checkbox"/> (Domestic Irrigation) <input type="checkbox"/> (Municipal, Industrial, Other)	<u>Sand</u>	<u>18</u>	

CODED


Information upon completion of well:

- (1) Diameter 2 inches.
- (2) Total Depth 178 feet.
- (3) Water Level 126 feet below top of ground.
- (4) Cased to _____, Size _____.
- (5) Screen: Size 90, Length 6 ft.
- (6) Were any formations sealed against pollution?
_____ yes, no.

If YES depth of formation _____

Why _____

Drillers Remarks: _____

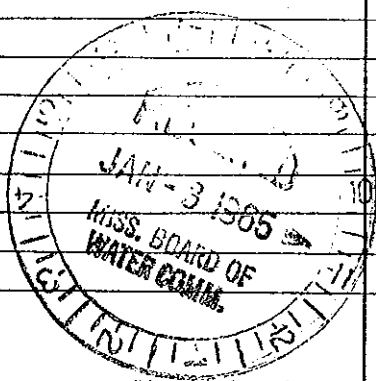

(Use Back Side)

Well No.

Mail this copy to Board of Water Commissioners 429 Miss. St. Jackson, Miss