

Desoto  
T 49  
8-66

MISSISSIPPI BOARD OF WATER COMMISSIONERS

WATER WELL DRILLERS LOG

**CODED**

Date: Aug 12, 1966, Driller: Shelly Neyman County Desoto  
(Name)

(1) Owner of Land: <u>J.W. Reid</u> (Name) <u>Eudoria Miss</u> (Address)	Description & Color of Materials Sand, Clay, Red Clay, Shell, etc.	Thick- ness Feet	Depth Feet
(2) Location: <u>SW 1/4, SW 1/4, Sec. 15 T3R1W</u> <u>1/2</u> miles <u>South</u> of <u>Eudoria</u> (distance) (direction) (Nearest Town)	<u>Red clay</u>	<u>40</u>	<u>40</u>
(3) Topography: <u>Hilly</u> (Hilly) (Flat) (Level)	<u>Red Sand Gravel</u>	<u>40</u>	<u>80</u>
(4) Purpose of Well: <u>Domestic</u> (Domestic Irrigation Municipal, Industrial, Other)	<u>Gravel</u>	<u>10</u>	<u>90</u>

**CODED**


Information upon completion of well:

- (1) Diameter 2 inches.
- (2) Total Depth 90 feet.
- (3) Water Level 70 feet below top of ground.
- (4) Cased to 82, Size 2 in.
- (5) Screen: Size 90, Length 6 ft.
- (6) Were any formations sealed against pollution?  
no

If YES depth of formation \_\_\_\_\_

Why \_\_\_\_\_

Drillers Remarks: \_\_\_\_\_

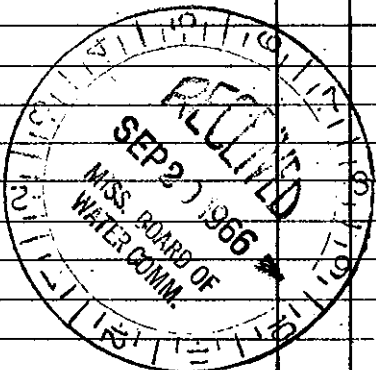

Well No. \_\_\_\_\_

(Use Back Side)

Mail this copy to Board of Water Commissioners 429 Miss. St. Jackson, Miss.