

Well #4 of 5 wells

DESO TO
751
3-67

MISSISSIPPI
BOARD OF WATER COMMISSIONERS
416 North State Street
Jackson, Mississippi 39201

CODED

WATER WELL DRILLERS LOG

3-13-67 date well completed 1967 ABEL WELL SUPPLY CO. firm name DESOTO county well located

LANDOWNER:
RICHARD H. HESSEY
TUNICA MISS (mailing address)

description of formations encountered	from	to
CLAY	1'	5'
BLACK SHOT	5'	15'
CLAY	15'	25'
COURSE SAND + GRAY CLAY	25'	74'

WELL LOCATION:
sec. 7 T. 14 S. R. 9 W.
1 1/2 miles SE of TUNICA (distance) (direction) (nearest town)

WELL PURPOSE: IRRIGATION (home, irrigation, municipal, industrial)

WELL COMPLETION DATA:

(1) diameter (inches) 10 3/4"

(2) total depth (feet) 74'

(3) static water level (feet) 7 below top of ground.

(4) casing 350# STEEL, 74' (material) (depth)

(size) if telescope see back.

(5) screen 30" 44' (length) (depth to top)

10 3/4" 55' WIRE WRAPPED SS (size) (material)

(6) pump 90 1200 240' (HP) (yield gpm)


(type power)

(7) electric log NO (yes or no)

(organization running log)

(8) how well bottom plugged STEEL

CODED

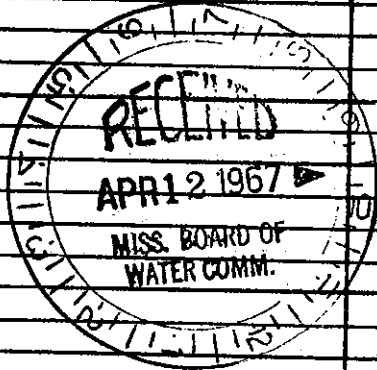

DRILLERS REMARKS: LEAK TO SET SURFACE CASING BLACK SHOT AHEAD BAD WHEN DRILLING