

WELL #5 of 5 well

DESO TO
J 52
3-67

MISSISSIPPI
BOARD OF WATER COMMISSIONERS
416 North State Street
Jackson, Mississippi 39201

CODED

WATER WELL DRILLERS LOG

3-17 date well completed 17 ADOL WELL SLURRY CO firm name DESOTO county well located

LANDOWNER:	description of formations encountered	from	to
RICHARD HUSSEY	Clay	1'	5'
TUNICA MISS (mailing address)	REPHASUAT	5'	15'
	Gum BO	15'	25'
	COARSE SAND + HEAVY GRAVEL	25'	74'


WELL LOCATION:
sec. 18 T. 4 S. R. 9 E
12 miles SE of TUNICA
(distance) (direction) (nearest town)

CODED

WELL PURPOSE: IRRIGATION
(home, irrigation, municipal, industrial)

WELL COMPLETION DATA:

- (1) diameter (inches) 10 3/4"
- (2) total depth (feet) 74'
- (3) static water level (feet) 7 below top of ground.
- (4) casing 250 STEEL (material), 74' (depth)
- (size) if telescope see back.
- (5) screen 30' (length), 144' (depth to top)
- 10 3/4" 55 WIRE WRAPPED (size) (material)
- (6) pump 50 (HP), 1200 @ 240' (yield gpm)
- PL TANK GAS (type power)
- (7) electric log NO (yes or no)
- (organization running log)
- (8) how well bottom plugged STEEL

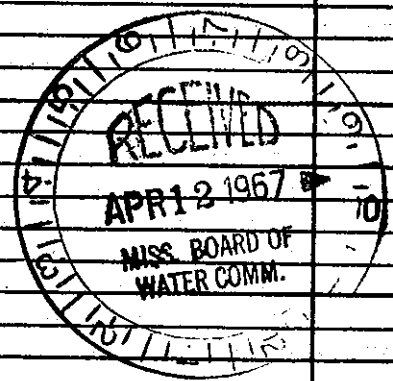

DRILLERS REMARKS: NEED TO SET SURFACE CASING BACK SHOT RUNS BAD WHEN DRILLING