

Desoto
J 53
7-67

MISSISSIPPI BOARD OF WATER COMMISSIONERS

CODED

WATER WELL DRILLERS LOG

Date: July, 1944, Driller: Harris, Bess County, Desoto
(When well drilled) (Name) (Where well is located)

(1) Owner of Land	Description & Color of Materials	Thick-ness Feet	Depth Feet
<u>Seloy Smith</u> (Name) <u>Eudora, Miss.</u> (Address)	<u>top soil</u>	<u>0</u>	<u>15</u>
(2) Location <u>NW 1/4, NE 1/4, Sec 16 39</u> <u>TSR</u>	<u>Red gravel & R. sand</u>	<u>15</u>	<u>60</u>
<u>1/10</u> miles <u>West</u> , of <u>Eudora</u> (distance) (direction) (Nearest Town)	<u>W. Clay & sand</u>	<u>60</u>	<u>85</u>
(3) Topography: <u>level</u> (Hilly) (Flat) (Level)	<u>W. sand</u>	<u>85</u>	<u>100</u>
(4) Purpose of Well: <u>domestic</u> (Domestic Irrigation Municipal, Industrial, Other)			

CODED

Information upon completion of well:

- (1) Diameter 4 inches.
- (2) Total Depth 100 feet.
- (3) Water Level 60 feet below top of ground.
- (4) Cased to 93', Size 4"
- (5) Screen: Size 4", Length 7'
- (6) Were any formations sealed against pollution?
yes, no.

If YES depth of formation _____


Why _____

Drillers Remarks: _____

Yield in gpm: 7

Size pump: 3/4 horse

Type power: electric

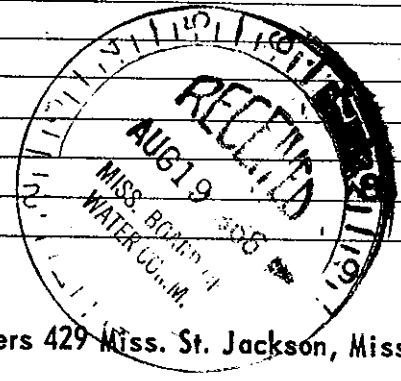

Mail this copy to Board of Water Commissioners 429 Miss. St. Jackson, Miss.