

CODED

MISSISSIPPI
BOARD OF WATER COMMISSIONERS
416 North State Street
Jackson, Mississippi 39201

WATER WELL DRILLERS LOG

DeSoto
9-58
7-68

July 19 19 68 Shelby Keyman Desoto
date well completed firm name county well located


LANDOWNER:	description of formations encountered	from	to
Russell Dees	Red clay	0	20
Lake Cormorant Mine	Red Sand	20	40
R. F. D.	Gravel Sand	40	65
(mailing address)	White Sand	65	82

WELL LOCATION:
sec. 9 T. 3 N. R. 9 E. S. W.
2 miles N of Eudoria
(distance) (direction) (nearest town)

WELL PURPOSE: Farm Home Power
(home, irrigation, municipal, industrial)

- WELL COMPLETION DATA:
- (1) diameter (inches) 2
 - (2) total depth (feet) 82
 - (3) static water level (feet) 22 below top of ground.
 - (4) casing Galvanne 76 (material) (depth)
 - (size) If telescope see back.
 - (5) screen 6 ft (length) (depth to top)
 - 1/4" Gauge (size) (material)
 - (6) pump Pitcher 12-15 (HP) (yield gpm)
 - Hand (type power)
 - (7) electric log no (yes or no)
 - W (organization running log)
 - (8) how well bottom plugged Rubber Seal

CODED

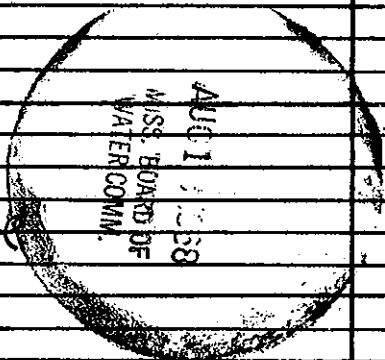

DRILLERS REMARKS: