

De Soto
 J 59
 8-68

MISSISSIPPI
 BOARD OF WATER COMMISSIONERS
 416 North State Street
 Jackson, Mississippi 39201

CODED

WATER WELL DRILLERS LOG

8-4-1968 Bob Smith DeSoto
 date well completed firm name county well located

LANDOWNER: Stefford description of formations encountered from to

Eudora, Miss (mailing address)
 top soil 0 20
 red clay 20 50
 red gravel 50 100

WELL LOCATION:
 sec. 4 T 3 N R 9 E
5 miles W of Eudora
 (distance) (direction) (nearest town)

WELL PURPOSE: Home
 (home, irrigation, municipal, industrial)

WELL COMPLETION DATA:
 (1) diameter (inches) 4
 (2) total depth (feet) 100
 (3) static water level (feet) 90 below above top of ground
 (4) casing plastic 100
 (material) (depth)


If telescope see back.
 (size)
 (5) screen 20 80
 (length) (depth to top)
4 plastic
 (size) (material)

(6) pump 1/2 10
 (HP) (yield gpm)
Ele
 (type power)

(7) electric log no
 (yes or no)
 (organization running log)

(8) how well bottom plugged plugged

CODED

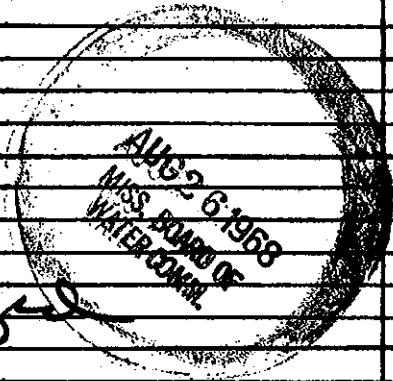

DRILLERS REMARKS:
good drilling