


De Soto
 J 96
 9-5-74

MISSISSIPPI
 BOARD OF WATER COMMISSIONERS CODED
 416 North State Street
 Jackson, Mississippi 39201

WATER WELL DRILLERS LOG

9-5-74 date well completed
 Pen ReMix firm name
 DeSoto county well located

LANDOWNER: Sarah Jones	description of formations encountered	from	to
Hernando, Missa (mailing address)	Clay sand mix sand	0	90
WELL LOCATION: sec. 32 T 3 N R 9 W 15 miles SW of Hernando (distance) (direction) (nearest town)			
WELL PURPOSE: (home, irrigation, municipal, industrial)			
WELL COMPLETION DATA: (1) diameter (inches) 2 1/2 (2) total depth (feet) 101 (3) static water level (feet) 30 below top of ground. (4) casing Galv. (material) (depth) 2 1/2 (size) If telescope see back. (5) screen 6 (length) 95 (depth to top) 1/2 (size) 6 (material) (6) pump 1/2 (HP) 250 (yield gpm/hr) (type power) (7) electric log no (yes or no) (organization running log) (8) how well bottom plugged Open	(1) (2) (3) (4) (5) (6) (7) (8)		
DRILLERS REMARKS:	MISS. BD. OF WATER COMM		

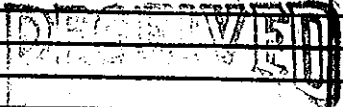

JAN 2 1975