

DESOTO  
J 101

MSCW  
15374  
15148

MISSISSIPPI DEPARTMENT OF NATURAL RESOURCES  
Bureau of Land and Water Resources  
Southport Mall  
P.O. Box 10631  
Jackson, Mississippi 39209  
WATER WELL DRILLERS LOG

7-18 19 98 Layne Central Div Desoto  
date well completed firm name county well located

LANDOWNER:	description of formations encountered	from	to
North Mississippi Utilities P.O. Box 362 Hernando, Ms 38632 (mailing address)	See Attached		
<b>WELL LOCATION:</b> sec. 16 T 3 N R 9 E 1 miles west of Eudora (distance) (direction) (nearest town)			
<b>WELL PURPOSE:</b> (home, irrigation, municipal, industrial)			
<b>WELL COMPLETION DATA:</b>			
(1) diameter (inches) 12"			
(2) total depth (feet) 1494			
(3) static water level (feet) 159 below top of ground.			
(4) casing Steel, 1405, (material), (depth) 12" (size) if telescope see back.			
(5) screen 81', 1410' (length), (depth to top) 8" (size), 304 S.S. (material)			
(6) pump 75 (HP), 557 (yield gpm) 460V (type power)			
(7) electric log Yes (yes or no) Layne (organization running log)			
(8) how well bottom plugged Back Pressure Valve			
<b>DRILLERS REMARKS:</b> Layne Contract # 574484			

**MISSISSIPPI DEPARTMENT OF NATURAL RESOURCES**

Bureau of Land and Water Resources

Southport Mall

P. O. Box 10631

Jackson, Mississippi 39209

**WATER WELL DRILLER'S LOG**

07/18/98

Layne Central Company

DeSoto

date well completed

firm name

county well located

LANDOWNER: North Mississippi Utilities

P. O. Box 362

Hernando, MS 38632

(mailing address)

WELL LOCATION: Hwy. 304 - Eudora, MS

sec. 16 T 3S R 9W

miles

of

(distance)

(direction)

(nearest town)

WELL COMPLETION DATA:

(1) diameter (inches) 12"

(2) total depth (feet) 1494'

(3) static water level (feet) 159' below above top of ground.

(4) casing Steel 1405'  
(material) (depth)

N/A if telescope see back.  
(size)

(5) screen 81' 1410'  
(length) (depth to top)

8" 304SST  
(size) (material)

(6) pump 75 557  
(HP) (yield gpm)

(7) electric log Yes  
(yes or no)

Ms. Dept. of Geology

(Organization running log)

(8) how well bottom plugged Grouted BPV

description of formations

encountered

from

to

See Attached

DRILLER'S REMARKS:

Well No. 3

TO  
103 J101  
-18-98

DeSoto Co.


J101

**FORMATION LOG OF THE WELL OR TEST HOLE**

STARTED TEST HOLE 5/27 1998 FINISHED 6/4 1998 TEST HOLE NUMBER 1  
 LOCATION Hwy. 304, Eudora, MS SEC \_\_\_\_\_ TS \_\_\_\_\_ RANGE \_\_\_\_\_ ELEVATION \_\_\_\_\_

TOTAL DEPTH	THICKNESS EACH STRATUM	FORMATION	TOTAL DEPTH	THICKNESS EACH STRATUM	FORMATION																											
49	49	Brown Clay			SAMPLES (CONT.)																											
65	16	Sand & Clay Streak	15.	835-865	23. 1457 - 1483																											
99	34	Sand & Gravel	16.	865-894	24. 1483 - 1509																											
101	2	Sand & Rock	17.	894-916	25. 1509 - 1540																											
118	17	Sand, Gravel, & Clay Streak	18.	985-1015	26. 1540 - 1569																											
131	13	Sand, Lignite, & Clay Streak	19.	1015-1045	27. 1569 - 1595																											
160	29	Hard Gray Clay	20.	1045-1072	28. 1595 - 1622																											
177	17	Sandy Clay	21.	1404-1430																												
213	36	Hard Clay	22.	1430-1457																												
215	2	Rock	MUD PIT SIZE _____ FT. X _____ FT. X _____ FT. DEEP																													
237	22	Hard Clay	TYPE BIT USED TO CUT SAND _____																													
268	31	Sandy Clay	SIZE OF TEST HOLE THROUGH SAND _____																													
374	106	Sand, Clay, & Lignite	TYPE OF BIT USED TO CUT UPPER FORMATIONS _____																													
511	137	Fine Sand, Shale, & Lignite	_____ SIZE _____																													
720	209	Fine Sand, Clay, & Lignite	TYPE MUD PUMP USED _____																													
916	196	Fine Sand, Lignite, & Shale Streak	DRILLING PRESSURE IN SAND _____																													
985	69	Shale, Lignite, & Sandy Streak	TYPE OF MUD USED _____																													
1072	87	Fine Sand, Shale, & Lignite Streak	NOTES: _____																													
1133	61	Shale, Lignite, & Sandy Streak	_____																													
1357	224	Hard Shale & Lignite	_____																													
1404	47	Sand, Shale, & Lignite Streak	_____																													
1551	147	Fine Sand, Lignite, & Shale Streak	_____																													
			<b>TEST DATA</b>																													
		SAMPLES	<table border="1" style="width: 100%;"> <thead> <tr> <th colspan="2">PRELIMINARY TEST</th> <th>FINAL TEST</th> </tr> </thead> <tbody> <tr> <td>STATIC WATER LEVEL</td> <td></td> <td>166'</td> </tr> <tr> <td>PUMPED G. P. M.</td> <td></td> <td>557</td> </tr> <tr> <td>PRESSURE, POUNDS</td> <td></td> <td>65</td> </tr> <tr> <td>DRAWDOWN</td> <td></td> <td>24</td> </tr> <tr> <td>G. P. F. D.</td> <td></td> <td>23.21</td> </tr> <tr> <td>GUARANTEED G. P. M.</td> <td></td> <td>500</td> </tr> <tr> <td>GUARANTEED PRESSURE</td> <td></td> <td>65</td> </tr> <tr> <td>DATE OF TEST</td> <td></td> <td>10/6/98</td> </tr> </tbody> </table>			PRELIMINARY TEST		FINAL TEST	STATIC WATER LEVEL		166'	PUMPED G. P. M.		557	PRESSURE, POUNDS		65	DRAWDOWN		24	G. P. F. D.		23.21	GUARANTEED G. P. M.		500	GUARANTEED PRESSURE		65	DATE OF TEST		10/6/98
PRELIMINARY TEST		FINAL TEST																														
STATIC WATER LEVEL		166'																														
PUMPED G. P. M.		557																														
PRESSURE, POUNDS		65																														
DRAWDOWN		24																														
G. P. F. D.		23.21																														
GUARANTEED G. P. M.		500																														
GUARANTEED PRESSURE		65																														
DATE OF TEST		10/6/98																														
	1.	371 - 418	REMARKS _____																													
	2.	418 - 444	_____																													
	3.	444 - 470	_____																													
	4.	470 - 496	_____																													
	5.	496 - 523	_____																													
	6.	523 - 553	_____																													
	7.	553 - 580	_____																													
	8.	580 - 606	_____																													
	9.	606 - 633	_____																													
	10.	633 - 660	_____																													
	11.	660 - 688	_____																													
	12.	688 - 717	_____																													
	13.	773 - 804	DRILLER <u>Barry Crook</u>																													
	14.	811 - 835	FIELD SUPT. <u>Ray Smith</u>																													

DRAWING OF THE WELL

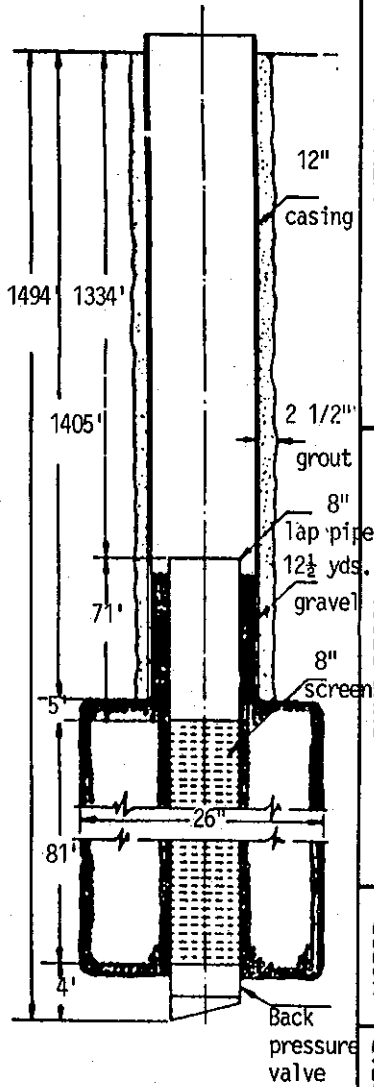

WELL DATA

STARTED WELL 5/27 1998 AND COMPLETED 7/18 1998  
 TOTAL DEPTH 1494' ELEVATION \_\_\_\_\_ STATIC WATER LEVEL 159'  
 LENGTH SURFACE CASING 119' SIZE 20" THICKNESS .375  
 CEMENTED WITH 60 SACKS CEMENT TYPE PACKER None  
 LENGTH WELL CASING 1405' SIZE 12" WEIGHT .375  
 CEMENTED WITH 1411 cft. SACKS CEMENT TYPE PACKER None  
 INNER CASING LENGTH 71' SIZE 8" WEIGHT .322  
 WITH Fish x Tail GUIDES LOCATED 5' top 5' bottom TYPE BACKOFF LH STD  
 LEAD SEAL \_\_\_\_\_ BACKPRESSURE VALVE Yes GUIDE \_\_\_\_\_  
 WELL STRAINER MAKE Johnson SIZE 8" LENGTH 81' OPENING 0.030  
 TYPE MATERIAL 304 SS WITH weld rings CONNECTIONS \_\_\_\_\_  
 SIZE HOLE DRILLED FOR SURFACE CASING 25" WITH rock  
 SIZE HOLE DRILLED FOR WELL CASING 17" WITH rock  
 SIZE HOLE DRILLED FOR STRAINER 26" WITH underreamer  
 YARDS OF GRAVEL USED 12.5 HOW PLACED Tremie  
 HOW WAS WELL DEVELOPED Air Agitation  
 NOTES: Gravelled with CSS 16 - 25 Sansaba

RIG USED GD 2500 DRILLER Barry Crook

PUMP RECORD

SERIAL NUMBER 117372 MAKE Layne FOUNDATION Concrete  
 LENGTH COLUMN 240' SIZE 8 X 2 X 1 3/16 TYPE Oil lube 3810 LENGTHS 9 X 38  
 BOWL SIZE 9" TYPE 9RCHC STAGES 8 MATERIAL IMPELLER Bronze  
 MATERIAL BOWL CI WITH open ports AND 1 3/16" SHAFT \_\_\_\_\_  
 SUCTION SIZE 6" LENGTH 20' SUCTION STRAINER No  
 IS PUMP SEALED HOW No WHERE \_\_\_\_\_ WITH WHAT \_\_\_\_\_  
 LUBRICATOR TYPE Lube Device SIZE 5 Quart VOLTAGE 460  
 LENGTH OF AIRLINE 240' SIZE 1/4" TYPE MATERIAL SST Tubing  
 AIR RELEASE VALVE TYPE None SIZE \_\_\_\_\_  
 SIZE SURFACE DISCHARGE 8" TYPE Flanged DAYTON COUPLING No  
 PRESSURE GAUGE None SPEED \_\_\_\_\_  
 NOTES Layne Head & Column Goulds Bowl

RIG USED TO SET PUMP National Crane INSTALLER Tommy Sullivan  
 DATE PUMP INSTALLED 9/28 1998 DATE IN OPERATION \_\_\_\_\_ 19\_\_\_\_

MOTOR

MAKE U.S. HP 75 FRAME 365TP PHASE 3 CYCLE 60 VOLT 460  
 SPEED 1775 MODEL 6327 SERIAL NUMBER \_\_\_\_\_  
 TOP BEARING \_\_\_\_\_ BOTTOM BEARING \_\_\_\_\_ RATCHET Yes  
 STARTER \_\_\_\_\_ PRESSURE SWITCH \_\_\_\_\_ FLOAT \_\_\_\_\_

GEAR

MAKE \_\_\_\_\_ MODEL \_\_\_\_\_ SIZE \_\_\_\_\_ RATIO \_\_\_\_\_ NO. \_\_\_\_\_  
 SIZE PULLEY \_\_\_\_\_ TYPE MOTOR FRAME \_\_\_\_\_

ENGINE

MAKE \_\_\_\_\_ MODEL \_\_\_\_\_ HP \_\_\_\_\_ SERIAL NUMBER \_\_\_\_\_  
 SPEED \_\_\_\_\_ SIZE PULLEY \_\_\_\_\_ FOUNDATION \_\_\_\_\_  
 TYPE FUEL TANK \_\_\_\_\_ MAKE MAG \_\_\_\_\_ NO. \_\_\_\_\_  
 MAKE STARTER \_\_\_\_\_ NO. \_\_\_\_\_ TYPE FUEL \_\_\_\_\_  
 MAKE FLEXIBLE SHAFT \_\_\_\_\_ SIZE \_\_\_\_\_ LENGTH \_\_\_\_\_ BELT LENGTH \_\_\_\_\_

GENERAL

PURPOSE FOR WHICH THIS WATER IS USED \_\_\_\_\_  
 TEMPERATURE \_\_\_\_\_ IS WATER CLEAR \_\_\_\_\_ CAPACITY \_\_\_\_\_  
 SAND \_\_\_\_\_ HARDNESS \_\_\_\_\_ PH \_\_\_\_\_ IRON \_\_\_\_\_ NaCl \_\_\_\_\_  
 TYPE TREATMENT USED \_\_\_\_\_  
 IS THERE A DERRICK OVER THE WELL \_\_\_\_\_ HEIGHT \_\_\_\_\_ TYPE \_\_\_\_\_  
 CAN TRUCK OR RIG EASILY GET TO WELL \_\_\_\_\_  
 PUMP HOUSE \_\_\_\_\_ SIZE HATCH \_\_\_\_\_

CONTRACT NO. 57 - 4484

OUR WELL NO. 1 THEIR WELL NO. 3 IN TEST HOLE NO. 1

LOCATION OF THE WELL Hwy. 304

INSTALLED FOR North Mississippi Utilities

ADDRESS CITY Eudora COUNTY Desoto STATE MS