State Well Report Part 1  Permit #: 6W-39814  Irrigation Equipment Date drilling completed:  Date drilling completed:  State Law requires that this report be prepared by the driller in detail and filed with the Department with 30 days of completion of drilling of the well.  State Well Report Part 1  Mississippi Department of Environmental Quality Office of Land and Water Resources P.O. Box 10631  Jackson, MS 39289-0631  (601)961-5210  (601)354-6938 (fax)  E-log #:  Well with the Department with 30 days of completion of drilling of the well.  Well Owner Information  Well Location  Lan Burns  Latitude:  "Longitude: "Longitud					
Permit #: 6W-39814  Irrigation Equipment Date drilling completed: 9-24-04  Date drilling completed: 9-24-04  State Law requires that this report be prepared by the driller in detail and filed with the Department with 30 days of completion of drilling of the well.  Well Coation  Mississippi Department of Environmental Quality Office of Land and Water Resources P.O. Box 10631  Jackson, MS 39289-0631  (601)961-5210  (601)354-6938 (fax)  E-log #:					
Office of Land and Water Resources  P.O. Box 10631  Jackson, MS 39289-0631  (601)961-5210  (601)354-6938 (fax)  State Law requires that this report be prepared by the driller in detail and filed with the Department with 30 days of completion of drilling of the well.  Well Owner Information  Well Location					
Date drilling completed:    9-24-04   Jackson, MS 39289-0631   L. S. Elevation:   (601)961-5210   (601)354-6938 (fax)   E-log #:   State Law requires that this report be prepared by the driller in detail and filed with the Department with 30 days of completion of drilling of the well.    Well Owner Information   Well Location   Well Location					
Date drilling completed:					
State Law requires that this report be prepared by the driller in detail and filed with the Department with 30 days of completion of drilling of the well.  Well Owner Information  Well Location					
State Law requires that this report be prepared by the driller in detail and filed with the Department wit 30 days of completion of drilling of the well.  Well Owner Information Well Location	h <b>in</b>				
Well Owner Information Well Location					
In Dunna					
	•				
Box 160					
lailing Address: Method of Lat/Long (circle one): Conventional Survey,	•				
USGS quad, Hand-held GPS, Survey-grade GPS					
Lake Cormorant, MS 38641  City State Zip Code  NW NE 4 Sec Twn 4S 9W  Rng					
City   State   Zip Code					
Well Data					
surpose of Well (circle one) Home Industrial Public Supply (Irrigation Fish Culture Other:					
tate well drilling started: $9-24-04$ Date well drilling completed: $9-24-04$					
flowing, method of flow regulation: Valve Other (describe)					
tatic Water Level: 20' feet above of below (circle one) land surface Date measured: 10-2-04					
fethod of Measurement (circle one) steel tape electric tape air line other:					
fole depth: 95' Well depth: 95' Well grouted to a depth of 10 feet					
ype of grout (circle one): Cement Bentonite Mix					
16 PMG GGH 40	•				
creen length: 29 feet Screen diameter: 16 inches Type of screen: PVC Sch. 40	-				
creen length: 29 feet Screen diameter: 16 inches Type of screen: PVC Sch. 40	-				
creen length: 29 feet Screen diameter: 16 inches Type of screen: PVC Sch. 40  See Back	 nent				
creen length: 29 feet Screen diameter: 16 inches Type of screen: PVC Sch. 40  creen slot size: 050 inches Setting depth: From See Back feet to feet	 nent				
creen length: 29 feet Screen diameter: 16 inches Type of screen: PVC Sch. 40  creen slot size: 050 inches Setting depth: From See Back feet to feet  ype of completion (circle all applicable): Cravel packed Underreamed Telescoped Open hole Natural Developm  Other (describe):					
creen length: 29 feet Screen diameter: 16 inches Type of screen: PVC Sch. 40  creen slot size: .050 inches Setting depth: From See Back feet to feet  ype of completion (circle all applicable): Gravel packed Underreamed Telescoped Open hole Natural Developm					

I certify that the well was drilled, constructed, and completed in accordance with all applicable requirements of the Mississippi

Department of Environmental Quality and/or the Mississippi Department of Health regulations and state laws.

Irrigation Equipment Inc. Patrick M. Chism 0695

Print Name of Water Well Contractor and License No.

OCT 11 2004


Signature of Water Well

Tf	well	telesco	Des n	lease	sketch	below	and	show	denths	5

J-117

Ground Level	Description of Formations Encountered	From	To	
	Clav	0	38	
ì	Fine Sand	39	4:0	
1	Med. Sand/gravel	41	65	
1	Fine Sand	66	70	
ļ	Med. Sand/gravel	71	74	
	Clav	75	95	
· j		T		
•				
· ·	Screen 41-65			
	Screen 71-74			
į				
<b>.</b>				
•				
	· • • • • • • • • • • • • • • • • • • •			

If more than one screen, show location of each on sketch

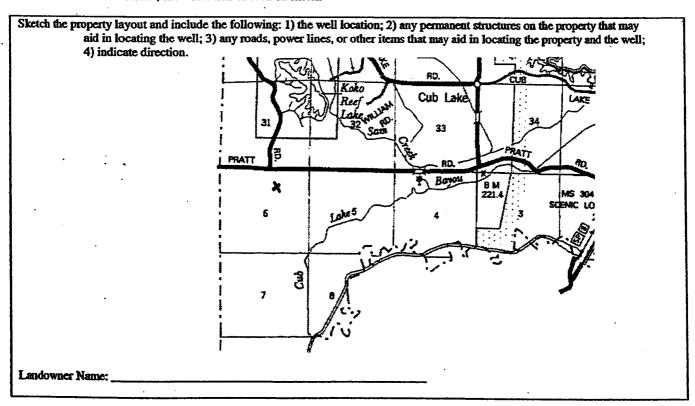

Signature of Water Well Contractor

## STATE WELL REPORT

## Part 2

Pump Installer's Completion Report
Mississippi Department of Environmental Quality
Office of Land and Water Resources
P.O. Box 10631
Jackson, MS 39289-0631
(601)961-5210

For Office Use Only:				
Aquifer:				
Well #: 5-117				
Elevation:				

Date completed: 10-2-04	(601)961-5210 (601)354-6938 (fax) Elevation:			
This report should be prepared by the pump installer in detail and filed with the Department within 30 days of the installation of pump.				
Well Owner Information	Well Location			
Owner Name: Lan Burns	Latitude: Longitude:			
Mailing Address: Box 160	Method of Lat/Long (circle one): Conventional Survey,			
Lake Cormorant, MS 38  City State Zip Code  662-781-4551  Telephone No. ()	USGS quad, Hand-held GPS, Survey-grade GPS    NW   NE   Sec   6   Twn   4S   Rng   9W     Distance			
Pump Type Circle one	Power Type Circle one			
Air Lift Jet Submersible	Voiesel Engine Gasoline Engine Natural Gas			
Bucket Piston (urbine)	Electric Motor Hand Tractor PTO			
Centrifugal Rotary Flowing Well	Windmill Other (specify):			
Other (specify):	Horse Power Rating of Motor: 40			
Date Pump Installed: 10-2-04	Setting Depth: 70 feet			
Rated Pump Capacity: 2000 Gallons Per Minut	te Number of Stages: 2			
Pump Test Data	Method of Measuring Water Level Circle one			
Date Well Tested:  Static Water Level (A):  Pumping Water Level (B):  Feet Below Land Surface  Feet Below Land Surface	Other (specify):			
Drawdown [(B) – (A)]: Feet Below Land Surface				
Test Pumping Rate: Gallons Per Minut				
Duration of Pump Test (minimum 4 hours):hour				
I HEREBY CERTIFY that the above statements are true to the Patrick M. Chism 0695  Print Name of Pump Installer and License No. (if applicable)	e best of my knowledge.  Latich M Music  Signature of Pump Installer			

**RECEIVED** 

OCT 1 1 2004

BY: OLWR