

# State Well Report

## Part I

Mississippi Department of Environmental Quality  
 Office of Land and Water Resources  
 P.O. Box 10631  
 Jackson, MS 39289-0631  
 (601)961-5210  
 (601)354-6938 (fax)

### For Office Use Only:

Aquifer: \_\_\_\_\_  
 Well #: 5-118  
 L. S. Elevation: \_\_\_\_\_  
 E-log #: \_\_\_\_\_

County: Desoto  
 Permit #: GW-39813  
 Irrigation Equipment  
 Driller: \_\_\_\_\_  
 Date drilling completed: 9-23-04

*Irrigation Equipment, Inc*

State Law requires that this report be prepared by the driller in detail and filed with the Department within 30 days of completion of drilling of the well.

Well Owner Information		Well Location	
Owner Name: <u>Lan Burns</u>	Latitude: <u>34</u> ° <u>45</u> ' <u>38N</u> "	Longitude: <u>90</u> ° <u>11</u> ' <u>33W</u> "	
Mailing Address: <u>Box 160</u>	Method of Lat/Long (circle one): <u>Conventional Survey</u>		
<u>Lake Cormorant, MS</u>	USGS quad, <u>Hand-held</u> GPS, Survey-grade GPS		
City: _____ State: _____ Zip Code: _____	NW <u>1/4</u> SE <u>1/4</u> Sec <u>6</u> Twn <u>4S</u> Rng <u>9W</u>		
Telephone No. (____) _____	Distance _____ Miles	Direction <u>SW</u>	Nearest Town <u>Hernando</u>

**Well Data**

Purpose of Well (circle one) Home Industrial Public Supply Irrigation Fish Culture Other: \_\_\_\_\_

Date well drilling started: 9-23-04 Date well drilling completed: 9-23-04

If flowing, method of flow regulation: Valve \_\_\_\_\_ Other (describe) \_\_\_\_\_

Static Water Level: 22' feet above or below (circle one) land surface Date measured: 10-2-04

Method of Measurement (circle one) steel tape electric tape air line other: \_\_\_\_\_

Hole depth: 96' Well depth: 96' Well grouted to a depth of 10 feet

Type of grout (circle one): Cement Bentonite Mix

Casing length: 36 feet Casing diameter: 16 inches Type of casing: PVC Sch. 40

Screen length: 60 feet Screen diameter: 16 inches Type of screen: PVC Sch. 40

Screen slot size: .050 inches Setting depth: From 37 feet to 96 feet

Type of completion (circle all applicable): Gravel packed Underreamed Telescoped Open hole Natural Development  
 Other (describe): \_\_\_\_\_

Top of lap pipe or reduction in casing: \_\_\_\_\_ feet. If telescoped or more than one screen, describe on back of page

Logs run (circle all applicable): No log run Electric Gamma Ray Density Sonic Neutron Other: \_\_\_\_\_

Name of organization running log(s): \_\_\_\_\_

I certify that the well was drilled, constructed, and completed in accordance with all applicable requirements of the Mississippi Department of Environmental Quality and/or the Mississippi Department of Health regulations and state laws.

Irrigation Equipment Inc.  
 Patrick M. Chism 0695

*Patrick M Chism*

Print Name of Water Well Contractor and License No.

Signature of Water Well Contractor

**RECEIVED**  
 OCT 11 2004  
 BY: OLWR

If well telescopes please sketch below and show depths.


J-118

Ground Level


Description of Formations Encountered	From	To
Clay	0	31
Clay/fine sand	32	35
Med. Sand/gravel	36	88
Clay	89	96

If more than one screen, show location of each on sketch

Sketch the property layout and include the following: 1) the well location; 2) any permanent structures on the property that may aid in locating the well; 3) any roads, power lines, or other items that may aid in locating the property and the well; 4) indicate direction.

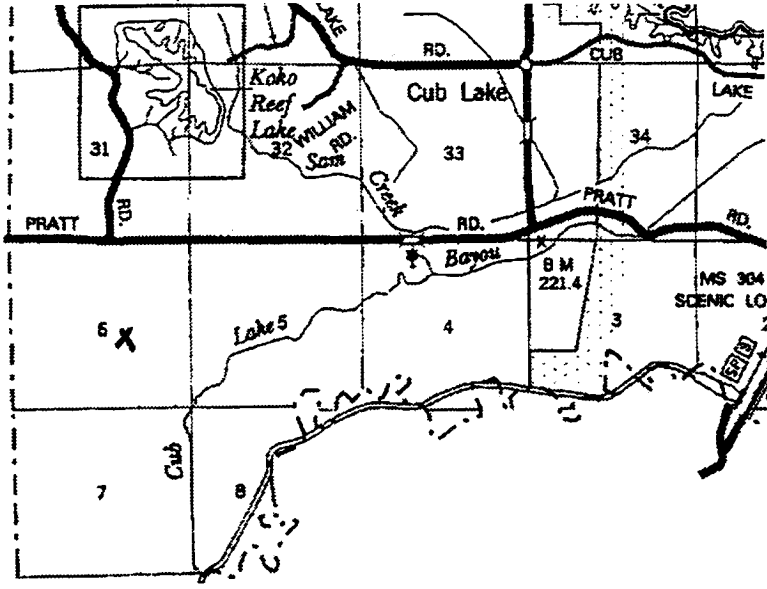

Landowner Name: \_\_\_\_\_

*Patrick M Chesin*  
 \_\_\_\_\_  
 Signature of Water Well Contractor

# STATE WELL REPORT

## Part 2

**Pump Installer's Completion Report**  
 Mississippi Department of Environmental Quality  
 Office of Land and Water Resources  
 P.O. Box 10631  
 Jackson, MS 39289-0631  
 (601)961-5210  
 (601)354-6938 (fax)

County: Desoto  
 Permit #: GW 39813  
 Irrigation Equipment  
 Driller: \_\_\_\_\_  
 Date completed: 10-2-04

For Office Use Only:

Aquifer: \_\_\_\_\_  
 Well #: 2-118  
 Elevation: \_\_\_\_\_

**This report should be prepared by the pump installer in detail and filed with the Department within 30 days of the installation of pump.**

Well Owner Information	Well Location
Owner Name: <u>Lan Burns</u>	Latitude: _____ Longitude: _____
Mailing Address: <u>Box 160</u>	Method of Lat/Long (circle one): Conventional Survey,
<u>Lake Cormorant, MS</u>	USGS quad, Hand-held GPS, Survey-grade GPS
City State Zip Code	NW <u>1/4</u> SE <u>1/4</u> Sec <u>6</u> Twn <u>4S</u> Rng <u>9W</u>
<u>662-781-4551</u>	Distance Direction Nearest Town
Telephone No. ( ) _____	<u>_____ Miles SW of Hernando</u>

Pump Type Circle one	Power Type Circle one
Air Lift Jet <input type="checkbox"/> Submersible <input type="checkbox"/>	<u>Diesel Engine</u> Gasoline Engine Natural Gas
Bucket Piston <input type="checkbox"/> <u>Turbine</u> <input type="checkbox"/>	Electric Motor Hand Tractor PTO
Centrifugal Rotary <input type="checkbox"/> Flowing Well <input type="checkbox"/>	Windmill Other (specify): _____
Other (specify): _____	Horse Power Rating of Motor: <u>60</u>
Date Pump Installed: <u>10-2-04</u>	Setting Depth: <u>70</u> feet
Rated Pump Capacity: <u>2500</u> Gallons Per Minute	Number of Stages: <u>2</u>

Pump Test Data	Method of Measuring Water Level Circle one
Date Well Tested: _____	Air Line Electric Measuring Line <u>Steel Tape</u>
Static Water Level (A): <u>22'</u> Feet Below Land Surface	Other (specify): _____
Pumping Water Level (B): _____ Feet Below Land Surface	For flowing well, measured shut in head: _____ feet
Drawdown [(B) - (A)]: _____ Feet Below Land Surface	Well yielded _____ GPM with a drawdown of
Test Pumping Rate: _____ Gallons Per Minute	_____ feet after _____ hours of pumping
Duration of Pump Test (minimum 4 hours): _____ hours	

I HEREBY CERTIFY that the above statements are true to the best of my knowledge.

Patrick M. Chism 0695 Patrick M Chism  
 Print Name of Pump Installer and License No. (if applicable) Signature of Pump Installer

RECEIVED  
 OCT 11 2004  
 BY: OLWR