

State Well Report

Part 1

Mississippi Department of Environmental Quality

Office of Land and Water Resources

P.O. Box 2309
Jackson, MS 39225

For Office Use Only

Aquifer: J 151

Well #: _____

L.S. Elevation: _____

E-Long #: _____

County: DESOTO
Permit #: _____
Driller: BOB SMITH
Date drilling complet: 8-9-10

State Law requires that this report be prepared by the driller in detail and filled will the Department within 30 days of completion of drilling of the well.

Well Owner Information	Well Location
Owner Name: <u>JERRY WILHITE</u>	Latitude: <u>34° 46' 25" S</u> Longitude: <u>90° 11' 28" W</u>
Mailing Address: <u>ROGWOOD DR</u>	Method of Lat/Long (circle one): Conventional Survey, USGS quad, Hand-held GPS, Survey-grade GPS
<u>HEMMING, MS 38632</u>	<u>NW 1/4 SE 1/4 Sec 17-19 Twn 735 Rng R29W</u>
City State Zip Code	Distance Direction Nearest Town
Telephone No. <u>901 465-6163</u>	<u>3 Miles S/W of EUDORA</u>

Well Data

Purpose of Well (circle one) Home Industrial Public Supply Irrigation Fish Culture Other _____

Date well drilling started: 8-9-10 Date well drilling completed: 8-9-10

If flowing, method of flow regulation: Valve _____ Other (describe) _____

Static Water Level: 50 feet above or below (circle one) land surface Date measured: 8-9-10

Method of Measurement (circle one) steel tape electric tape air line other: LINE & WEIGHT

Hole Depth: 60 Well depth: 60 Well grouted to a depth of 10 feet

Type of grout: (circle one) Cement Bentonite Mix

Casing length: 40 feet Casing diameter: 4 inches Type of casing: PVC

Screen length: 20 feet Screen diameter: 4 inches Type of screen: PVC

Screen slot size: 13 MESH inches Setting depth: From 40 feet to 60 feet

Type of completion (circle all applicable):
Gravel packed Underreamed Telescoped Open hole Natural Development
Other (describe): _____

Top of lap pipe or reduction incasing: _____ feet. If telescoped or more than one screen, describe on back

Logs run (circle one): No log run Electric Gamma Ray Density Sonic Neutron Other: _____

Name of organization running log(s): _____

I certify that the well drilled, constructed, and completed in accordance with all applicable requirements of the Mississippi Department of Environmental Quality and/or the Mississippi Department of Health regulations and state laws.

BOB SMITH 0-645
Print name of Water Contractor and License No.

[Signature]
Signature of Water Well Contractor

RECEIVED
SEP 10 2010
BY: OLWR

State Well Report

Part 2

Pump Installer's Completion Report
Mississippi Department of Environmental Quality
Office of Land and Water Resources
P.O. Box 2309
Jackson, MS 39225

For Office Use Only

Aquifer: J/S
Well #: _____
Elevation: _____

County: DESOTO
Permit #: _____
Driller: Bob Smith
Date completed: 8-9-10

This report be prepared by the pump installer in detail and filed with the Department within 30 days of completion of drilling of the well.

Well Owner Information	Well Location
Owner Name: <u>Jerry White</u>	Latitude: _____ Longitude: _____
Mailing Address: <u>DOGWOOD DR</u>	Method of Lat/Long (circle one): Conventional Survey
<u>Hennepin, MS. 38632</u>	USGS quad, Hand-held GPS, survey grade GPS
City State Zip Code	<u>1/4 1/4 Sec 11-19 Twn 135 Rng 12 W</u>
Telephone No. <u>(901) 465-6163</u>	Distance Direction Nearest Town
	<u>3 miles S/W of EUDORA</u>

Pump Type Circle one	Power Type Circle one
Air lift Jet <u>Submersible</u>	Diesel Engine Gasoline Engine Natural Gas
Bucket Piston Turbine	<u>Electric Motor</u> Hand Tractor PTO
Centrifugal Rotary Flowing Well	Windmill Other(specify): _____
Other (specify): _____	Horse Power Rating of Motor: <u>3/4</u>
Date Pump Installed: <u>8-9-10</u>	Setting Depth: <u>60</u> feet
Rated Pump Capacity: <u>10</u> gallons per min	Number of Stages: <u>8</u>

Pump Test Data	Method of Measuring Water Level circle one
Date Well Tested: <u>8-9-10</u>	Air Line Electric Measuring Line Steel Tape
Static Water Level(A): <u>50</u> feet below Land Surface	Other(specify): <u>LINE WEIGHT</u>
Rumping Water Level(B): _____ feet below Land Surface	For flowing well, measured shut in head: _____ feet
Drawdown((B)-(A)): _____ feet below Land Surface	Well yielded <u>4</u> GPM with a drawdown of _____ feet after _____ hours of pumping
Test Pumping Rate: <u>4</u> gallons per Minute	
Duration of Pump Test(minimum 4 hours): _____ hrs	

I HEREBY CERTIFY that the above statements are true to the best of my knowledge.


Bob Smith 0645 _____
Print Name of Pump Installer and License No. Signature of Pump Installer

RECEIVED
SEP 10 2010
BY: OLWP

Ground Level

Description of Formations Encountered	From	To
TOP SOIL	0	5
Brown CLAY	5	13
WHITE CLAY	13	42
RED SAND - GRAVEL	42	60

If more than one screen, show location of each on sketch

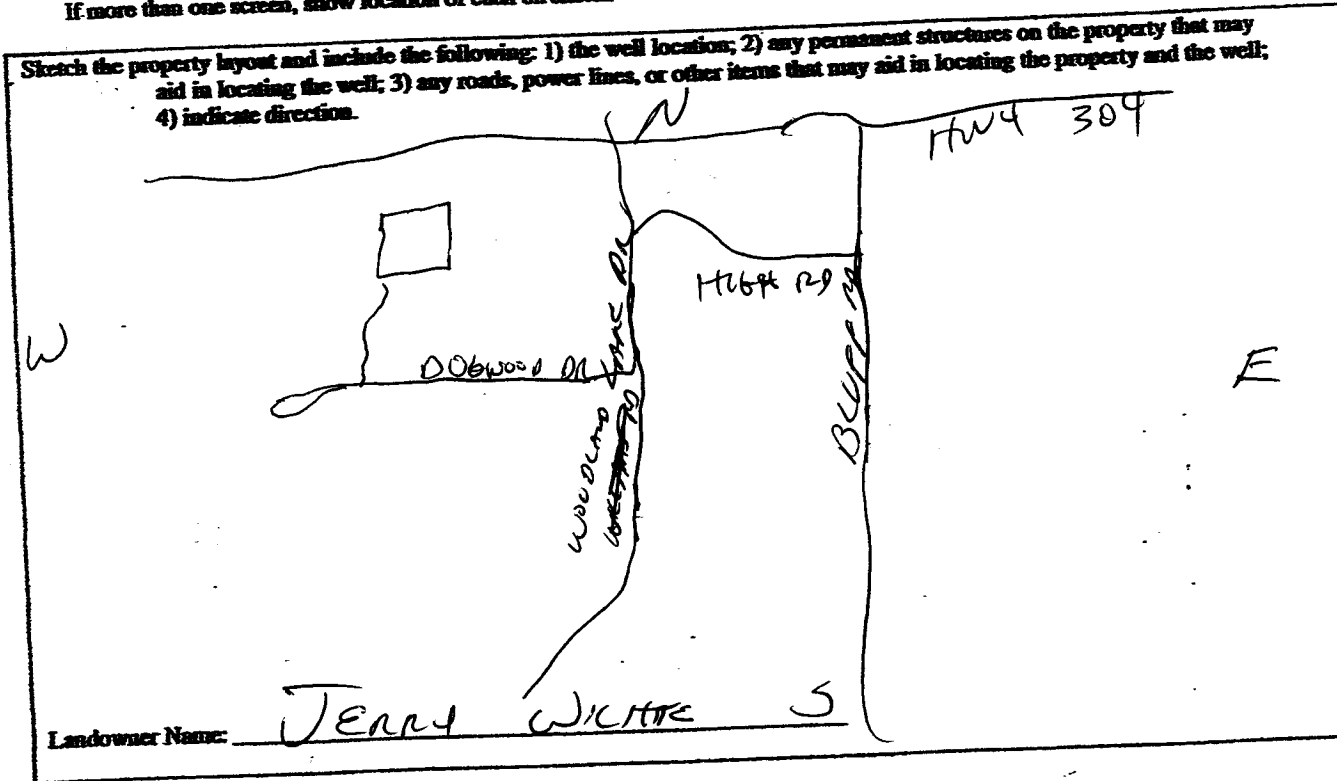

[Handwritten Signature]

 Signature of Water Well Contractor

RECEIVED
 SEP 10 2010
 BY: OIWF