

STATE WELL REPORT

Part 1

Driller's Log

Mississippi Department of Environmental Quality
 Office of Land and Water Resources
 P.O. Box 2309
 Jackson, MS 39275-2309
 (601)954-5248
 (601)368-1535 (fax)

For Office Use Only:

Well: J174
 Aquifer: _____
 Filing #: _____

County: DeSoto
 Permit #: _____
 Driller: Bob Smith
 Date drilling completed: 4-8-20

State Law requires that this report be prepared by the licensee holder responsible for the work and filed with the Department at the above address within 30 days of completion of drilling of the well or borehole.

Well Owner Information <i>(Licensee if borehole is not for a water well)</i>		Well or Borehole Location	
Owner Name: <u>Venue Homes</u>		Latitude: <u>34°50'16.51</u>	Longitude: <u>90°7'54.99</u>
Mailing Address: <u>1529 BROWN</u>		Method of Lat/Long (check one):	Conventional Survey _____
<u>NO</u>		USGS quad _____	Hand-held GPS _____
<u>Hennando MS 38632</u>		Survey-grade GPS _____	
City _____	State _____	Zip Code _____	
Telephone No. <u>(901) 997-8677</u>		NE $\frac{1}{4}$ SE $\frac{1}{4}$ Sec <u>10</u> T <u>3S</u> R <u>9W</u>	
		Miles _____	of _____
		(Distance)	(Direction) (Nearest Town)

Well / Borehole Data

Date drilling started: 4-8-20 Date drilling completed: 4-8-20 Hole depth: 102 Hole diameter: 8"

Location of the source of any surface water used for drilling: _____

Method of dosing and volume of Chlorine used in drilling and development: 5 PPM

Log run (circle all applicable): No log run Electric Gamma Ray Density Sonic Neutron Other _____

Name of organization running log(s): _____

Purpose of borehole (circle one): Water Well Geotechnical/Geological Investigation Ground Source Heat Pump Seismic Survey Other (describe) _____

If drilling is not related to water well construction, skip the remainder of this page.

Purpose of Well (circle all applicable): Home Industrial Public Supply Irrigation Fish Culture

Other (describe): _____

If a flowing well, method of flow regulation: Valve _____ Other (describe) _____

Static Water Level: 70 feet above or below land surface Date measured: 4-8-20
 (circle one)

Method of measurement (circle one): Steel tape Electric tape Air line Other (describe) _____

Well depth: 102 Well grouted to a depth of: 10 feet Type of grout (circle one): Neat Cement Bentonite Mix _____

Casing length: 82 feet Casing diameter: 4 inches Type of casing: PVC

Screen length: 20 feet Screen diameter: 4 inches Type of screen: PVC

Screen slot size: 12 TYDUS inches Setting depth: From 82 feet to 102 feet

Type of completion (circle all applicable): Sealed packer Underreamed Open hole Natural Development

Other (describe): _____

Top of top pipe or restriction in casing: _____ feet

If telescoped or more than one screen, describe on next page

RECEIVED
 JUN 01 2020
 BY OLWR

STATE WELL REPORT

Part 2

Pump Installer's Completion Report
 Mississippi Department of Environmental Quality
 Office of Land and Water Resources
 P.O. Box 2309
 Jackson, MS 39225-2309
 (601) 961-5210
 (601) 368-0535 (fax)

For Office Use Only:

Well #: J 174
 Aquifer: _____

County: DESOUD
 Permit #: _____
 Driller: BOB SMITH
 Date completed: 4-8-20
Copy information from block on Part 1

This part of the report must be completed by a licensed water well contractor or a licensed pump installer. A copy of Part 1 of the report must be attached and both parts filed with the Department at the above address within 30 days of well completion.

Well Owner Information	Well Location
Owner Name: <u>VENUE Homes</u>	Latitude: <u>34°50'16.51</u> Longitude: <u>90°7'54.99</u>
Mailing Address: <u>1529 BARLOW RD</u>	Method of Lat/Long (check one): Conventional Survey _____
<u>HEMLOCK MS 38632</u>	USGS quad _____ Hand-held GPS _____ Survey-grade GPS _____
City _____ State _____ Zip Code _____	<u>NE</u> ¼ <u>SE</u> ¼, Sec. <u>10</u> T. <u>35</u> R. <u>9W</u>
Telephone No. <u>906 497 8677</u>	_____ Miles _____ of _____ (Nearest Town)
	(Distance) (Direction)

Pump Type (circle one)

Submersible Turbine Air Lift Centrifugal Flowing Well Jet Piston Rotary Other (describe): _____

Date Pump installed: 4-8-20 Rated Pump Capacity: 10 Gallons Per Minute

Is This Pump (circle one): New Repaired Replacement

Power Type (circle one)

Electric Diesel Gasoline Natural Gas Tractor PTO Windmill Other (describe): _____

Horse Power Rating of Motor: 3/4 Setting Depth: 60 feet Number of Stages: 8

Pump Test Data for Non Flowing Well

Date Well Tested: 4-8-20 Duration of Pump Test (minimum 4 hours): _____ hours

Static Water Level (A): 20 Feet Below Land Surface Pumping Water Level (B): _____ Feet Below Land Surface

Drawdown [(B) - (A)]: _____ Feet Below Land Surface Test Pumping Rate: 15 Gallons Per Minute

Method of measurement (circle one): Steel tape Electric tape Air line Other (describe): _____

Pump Test Data for Flowing Well

Measured static head: _____ feet

Well yielded _____ GPM with a drawdown of _____ feet after _____ hours of pumping

Meter Installation

Meter Manufacturer: _____ Meter Serial Number: _____

Meter Model Number/Name: _____ Type of Meter: _____

Totalizer Register Unit and Multiplier Factor (AF x .001, gal x 1000, etc): _____

Installation Date: _____ Meter installed by: _____

Is This Meter (circle one): New Repaired Replacement

Important: By submitting the above information you are certifying that this meter was installed to manufacturer standards. For agricultural wells, a list of approved meters is on the MDEQ website.

I HEREBY CERTIFY that the above statements are true to the best of my knowledge.


BOB SMITH 0645 5-27-20 JM L...
 Print Name of Pump Installer and License No. (if applicable) Date Signature of Pump Installer

County: DE SOTO
 Permit #: _____

For Office Use Only:
 Well #: _____

The sketch below only required for water wells
If well telescopes, show depths on sketch.

Description of formations encountered must be provided for all wells and boreholes, unless specifically exempted by regulations

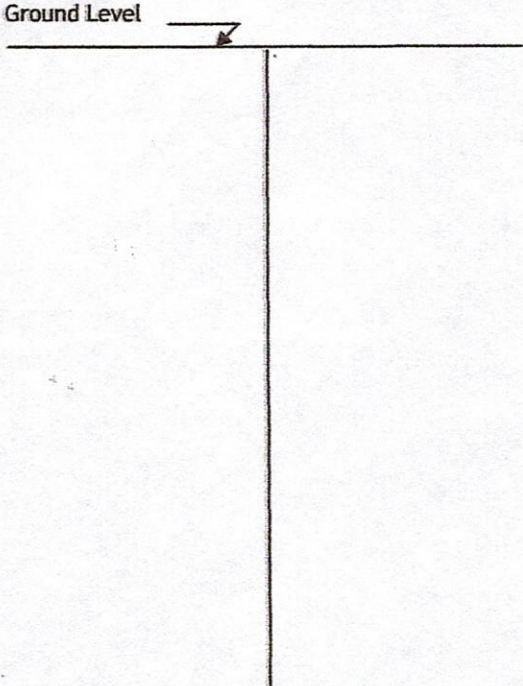


Description of Formations Encountered	From (depth)	To (depth)
TOP SOIL	Ground level	5
BROWN CLAY	5	12
WHITE CLAY	12	60
GRAVEL + SAND	60	102
ROCK	102	

If more than one screen, show location of each on sketch

F-69

Sketch the property layout and include the following:
 1) the well location
 2) any permanent structures on the property that may aid in locating the well
 3) any roads, power lines, or other items that may aid in locating the property and the well
 4) north arrow

RECEIVED
 JUN 01 2020
 BY OLWR

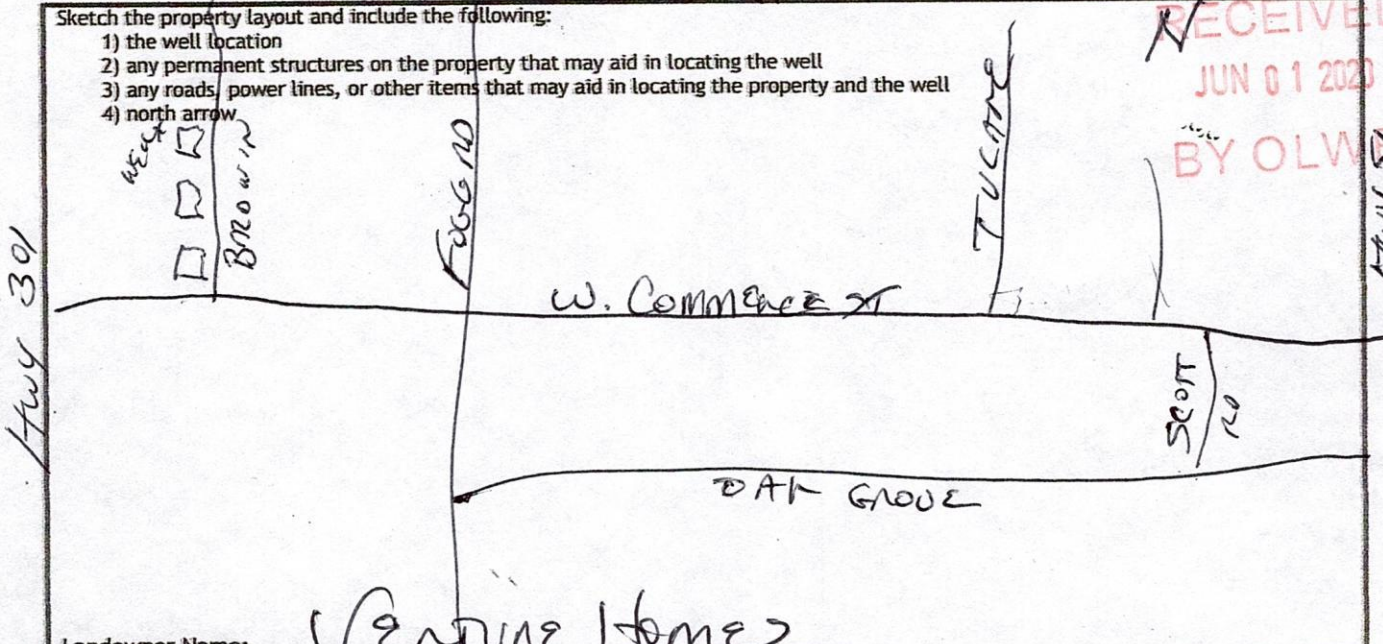

Landowner Name: Venture Homes

I HEREBY CERTIFY that the well/borehole was drilled, constructed, and completed in accordance with all applicable requirements of the Mississippi Department of Environmental Quality and the Mississippi Department of Health regulations, if applicable, and state laws.

BOB SMITH 0-645 5-27-20 [Signature]
 Print Name of Responsible Licensee and License No. Date Signature of Licensee