

Desoto  
**200 WATER WELL DRILLERS LOG**

Date: 5-27-62 1962, Driller: H & H Well Co Desoto County

(1) Owner of Land: 117 Rowan  
H H Well Co  
 (Name)  
 (Address)

(2) Location: 13 West 18 39<sup>N</sup>  
 (distance) miles (direction) Of (Nearest Town)

(3) Topography: X  
 (Hilly) (Flat) (Level)


(4) Purpose of Well: irrigation  
 (Domestic Irrigation, Municipal, Industrial, Other)

Description & Color of Materials Sand, Clay, Red Clay, Shell, etc.	Thick- ness	Depth
<u>70' red clay</u>	<u>70'</u>	<u>231'</u>
<u>greenish sand rock</u>	<u>6'</u>	
<u>hard clay</u>	<u>4'</u>	
<u>streak clay streak</u>	<u>80'</u>	
<u>sand</u>	<u>40'</u>	
<u>lite sand (fine)</u>	<u>31'</u>	

Information upon completion of well:

- (1) Diameter 2" inches.
- (2) Total Depth 231 feet.
- (3) Water Level 45' feet below top of ground.
- (4) Cased to 210 Size 2"
- (5) Screen: Size 1/4, Length 10' with Bull lock 1/4 x 18'
- (6) Were any formations sealed against pollution?  
 yes,  no.

Jet Pump

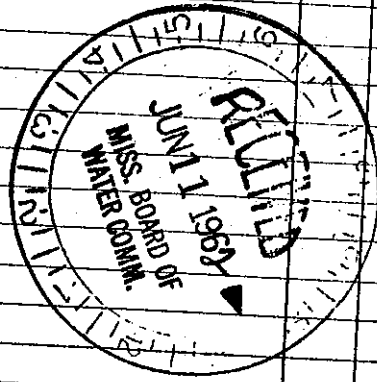

16

Well No.

(Use Back Side)

Retain this copy for your office files.