


Desoto

J 2003 MISSISSIPPI BOARD OF WATER COMMISSIONERS
6-66

WATER WELL DRILLERS LOG

Date: June 19 1966, Driller: Harry Brown, County Desoto
(When well drilled) (Name) (Where well is located)

(1) Owner of Land: <u>George Murphy</u> (Name)	Description & Color of Materials Sand, Clay, Red Clay, Shell, etc.	Thick- ness Feet	Depth Feet
<u>Eudora</u> (Address)	<u>top soil</u>	<u>0</u>	<u>10</u>
(2) Location: <u>1/4, 1/4, Sec. 10 T 39 R</u>	<u>red sand</u>	<u>10</u>	<u>30</u>
_____ miles _____ of _____ (distance) (direction) (Nearest Town)	<u>red clay + sand</u>	<u>30</u>	<u>65</u>
(3) Topography: <u>hilly</u> (Hilly) (Flat) (Level)	<u>coarse w. sand</u>	<u>65</u>	<u>77</u>
(4) Purpose of Well: <u>Domestic</u> (Domestic Irrigation Municipal, Industrial, Other)			
Information upon completion of well:			
(1) Diameter <u>4</u> inches.			
(2) Total Depth <u>77</u> feet.			
(3) Water Level <u>30</u> feet below top of ground.			
(4) Cased to <u>70</u> , Size <u>4"</u>			
(5) Screen: Size <u>4"</u> , Length <u>7'</u>			
(6) Were any formations sealed against pollution? _____ yes, _____ no.			
If YES depth of formation _____			
Why _____			
Drillers Remarks: _____			
Yield in gpm: <u>10</u>			
Size pump: <u>3/4</u>			
Type power: <u>electric</u>			

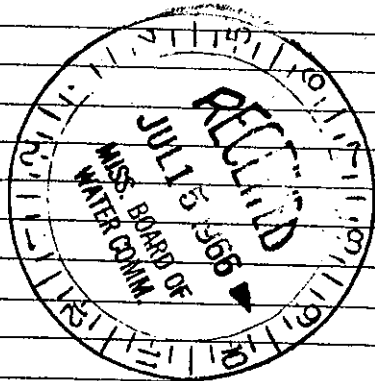

Mail this copy to Board of Water Commissioners 429 Miss. St. Jackson, Miss.