

DEBOTO MISSISSIPPI BOARD OF WATER COMMISSIONERS

J
8-16-60

WATER WELL DRILLERS LOG

Date: 8-16, 1960, Driller: A.C. Henderson County DeWitt
(Name)

(1) Owner of Land: Malcom Corp
(Name)
RT 1 Hernando mts
(Address)
(2) Location: 39 W of Hernando
12 miles (distance) (direction) (Nearest Town)
(3) Topography: X (Hilly) (Flat) (Level)
(4) Purpose of Well: Home Use
(Domestic Irrigation, Municipal, Industrial, Other)


Description & Color of Materials Sand, Clay, Red Clay, Shell, etc.	Thick- ness Feet	Depth Feet
<u>Red clay</u>	<u>40</u>	<u>68'</u>
<u>Shale clay</u>	<u>10</u>	
<u>Sand</u>	<u>18</u>	

Information upon completion of well:

(1) Diameter 2 inches.
(2) Total Depth 68 feet.
(3) Water Level 56 feet below top of ground.
(4) Cased to 68, Size 2"
(5) Screen: Size 1/4, Length 6'
(6) Were any formations sealed against pollution?
_____ yes, _____ no.

#0052
lat 51

If YES depth of formation _____
Why _____
Drillers Remarks: _____

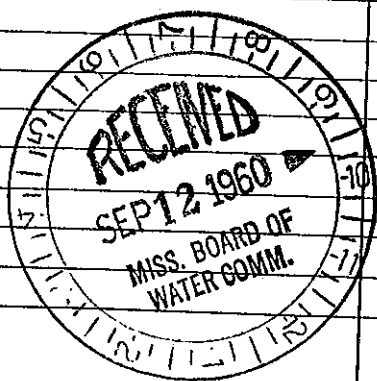

(Use Back Side)

Well No. 7

Mail this copy to Board of Water Commissioners 429 Miss. St. Jackson, Miss.