

Desoto

MISSISSIPPI BOARD OF WATER COMMISSIONERS

J 2005
8-10-60

WATER WELL DRILLERS LOG

Date: 8-10, 1960, Driller: H.C. Sanders, County Desoto

(1) Owner of Land: (Name)	Description & Color of Materials Sand, Clay, Red Clay, Shell, etc.	Thick- ness Feet	Depth Feet
Dor Rutherford RT 1 (Address)	10' Red + blue Clay	10	28
(2) Location: 1/4, 1/4, Sec. 32 T 39 W	small gravel & sand	18	
1.2 miles SW, of Hernando (distance) (direction) (Nearest Town)			
(3) Topography: (Hilly) (Flat) (Level)			
(4) Purpose of Well: Home (Domestic Irrigation Municipal, Industrial, Other)			

Information upon completion of well:


- (1) Diameter 2 inches.
- (2) Total Depth 48 feet.
- (3) Water Level 70 feet below top of ground.
- (4) Cased to 88, Size 2"
- (5) Screen: Size 1/4, Length 6'
- (6) Were any formations sealed against pollution?
yes, no.

#0052

If YES depth of formation

Why

Drillers Remarks:

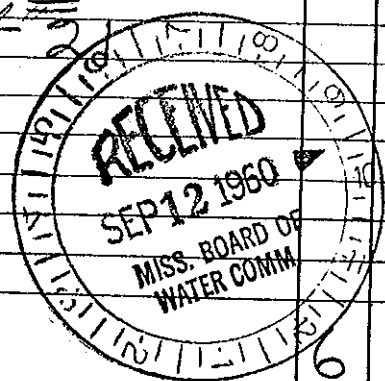

(Use Back Side)

Well No. 6

ail this copy to Board of Water Commissioners 429 Miss. St. Jackson, Miss.