

DESOTO

J 2008 WATER WELL DRILLERS LOG

J-301

7-61

Date: July, 1961, Driller: J. E. Henderson County Desoto

(1) Owner of Land:	Description & Color of Materials Sand, Clay, Red Clay, Shell, etc.	Thick- ness Feet	Depth Feet
J. E. Henderson (Name)	Red clay	6.5	
Cuda (Address)	Red sand	10	
(2) Location: 1/4, 1/4, Sec. 39 T. R.	White sand	25	
1/4 miles West of (Distance) (Direction) (Nearest Town)			100'
(3) Topography: Hilly (Flat) (Level)			
(4) Purpose of Well: Domestic Irrigation (Municipal, Industrial, Other)			

Information upon completion of well:


#0052

- (1) Diameter 4" inches.
- (2) Total Depth 100' feet.
- (3) Water Level 6.5' feet below top of ground.
- (4) Cased to 100', Size 4"
- (5) Screen: Size 1/4", Length 10' Plastic
- (6) Were any formations sealed against pollution?  
yes, no.

If YES depth of formation

Why

Drillers Remarks:

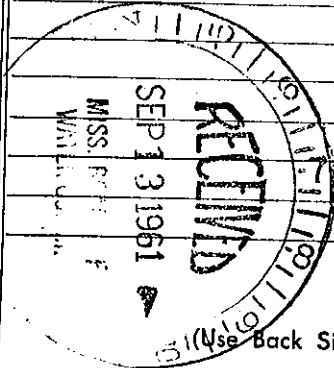

(Use Back Side)

Well No.

Retain this copy for your office files.