

DESOTA
J 2013
3-17-76

MISSISSIPPI
 BOARD OF WATER COMMISSIONERS
 416 North State Street
 Jackson, Mississippi 39201

WATER WELL DRILLERS LOG

3-17-1976 *Bob Sutt Well Co.* *Desoto*
 date well completed firm name county well located

LANDOWNER:

James E. Edwards

Hernando, Ms.
 (mailing address)

WELL LOCATION:

sec. 31 T. 3 N. R. 9 E.
9 miles (distance) S (direction) of Hernando (nearest town)

WELL PURPOSE: Home
 (home, irrigation, municipal, industrial)

WELL COMPLETION DATA:

- (1) diameter (inches) 4"
- (2) total depth (feet) 82'
- (3) static water level (feet) 50 below above top of ground.
- (4) casing plastic 82'
 (material) (depth)
 (size) if telescope see back.
- (5) screen 10' 72'
 (length) (depth to top)
4"
 (size) plastic
 (material)
- (6) pump 1/2 5
 (HP) (yield gpm)
Electric
 (type power)
- (7) electric log no
 (yes or no)

(organization running log)


(8) how well bottom plugged plugged

DRILLERS REMARKS:

description of formations encountered

from to

<i>top soil</i>	<i>0</i>	<i>5</i>
<i>red clay</i>	<i>5</i>	<i>40</i>
<i>1" gravel</i>	<i>40</i>	<i>60</i>
<i>white sand</i>	<i>60</i>	<i>82</i>

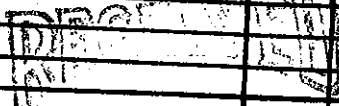

MAY 27 1976

MISS. BD. OF WATER COMM