


DESOTO
J 2016
4-16-76

MISSISSIPPI
 BOARD OF WATER COMMISSIONERS
 416 North State Street
 Jackson, Mississippi 39201

WATER WELL DRILLERS LOG

4-16-76 date well completed 158 Bob Smith W.M.S. firm name Desoto county well located

| LANDOWNER: | description of formations encountered | from | to |
|--|---------------------------------------|------|-----|
| Barney Riley | top soil | 0 | 5 |
| Skanska, Inc. (mailing address) | red clay | 5 | 65 |
| WELL LOCATION: | gravel | 65 | 90 |
| sec. 30 T. 3 N. R. 9 E. 6 miles SW of Eudora (distance) (direction) (nearest town) | blue clay | 90 | 120 |
| WELL PURPOSE: Home (home, irrigation, municipal, industrial) | fine sand | 120 | 170 |
| WELL COMPLETION DATA: | | | |
| (1) diameter (inches) 4" | | | |
| (2) total depth (feet) 170 | | | |
| (3) static water level (feet) 100 below top of ground. | | | |
| (4) casing plastic (material) (depth) (size) if telescope see back. | | | |
| (5) screen 10' 160' (length) (depth to top) | | | |
| (6) pump 4" plastic (size) (material) | | | |
| (6) pump 1/2 10 (HP) (yield gpm) E. M. (type power) | | | |
| (7) electric log no (yes or no) | | | |
| (organization running log) | | | |
| (8) how well bottom plugged plugged | | | |
| DRILLERS REMARKS: | | | |

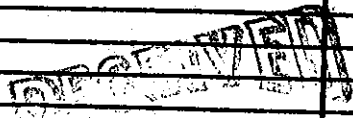

MAY 28 1976

MISS. BD. OF WATER COMM.