

Desoto

Date: 3-15-1961, Driller: A.C. Henderson County, Desoto

(Name)

3-15-61
(1) Owner of Land: M. Brown

(Name)

Moore Town

(Address)

(2) Location: 1/4, 1/4, Sec. 28 T4 R8

6 miles SW, of Hernando

(distance)

(direction)

(Nearest Town)

(3) Topography: X

(Hilly)

(Flat)

(Level)

(4) Purpose of Well: Home

(Domestic Irrigation
Municipal, Industrial, Other)

Description & Color of Materials
Sand, Clay, Red Clay, Shell, etc.

Thick-
ness
Feet

Depth
Feet

Red Clay

40

80

Gravel + Red Sand

20

Clay

2'

White Sand

16

Information upon completion of well:

(1) Diameter 2 inches.

0052

(2) Total Depth 80 feet.

(3) Water Level 50' feet below top of ground.

(4) Cased to 76, Size 2

(5) Screen: Size 1/4", Length 6


(6) Were any formations sealed against pollution?

yes, no.

If YES depth of formation

Why

Drillers Remarks:

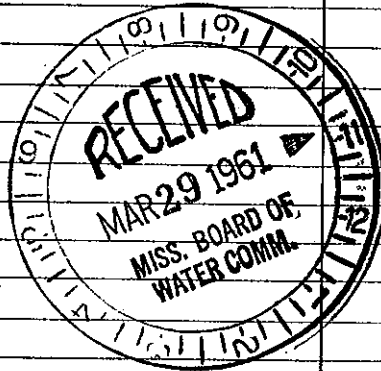

18

Well No.

(Use Back Side)

Retain this copy for your office files.