


Desoto WATER WELL DRILLERS LOG

Date: 9-18-61, 1961, Driller: Mc Henderson County Desoto
(Name)

(1) Owner of Land: <u>Bell Jacoby</u> <small>(Name)</small>	Description & Color of Materials Sand, Clay, Red Clay, Shell, etc.	Thick- ness Feet	Depth Feet
<u>RT 1</u> <small>(Address)</small>	<u>40" Red clay</u>	<u>40</u>	<u>60'</u>
(2) Location: <u>1/4</u> , <u>1/4</u> , Sec. <u> </u> T <u> </u> R <u> </u>	<u>Sand & gravel</u>	<u>20'</u>	
<u>7</u> miles <u>West</u> of <u>Hendon</u> <small>(distance) (direction) (Nearest Town)</small>			
(3) Topography: <u>X</u> <small>(Hilly) (Flat) (Level)</small>			
(4) Purpose of Well: <u>Home use</u> <small>(Domestic Irrigation Municipal, Industrial, Other)</small>			
Information upon completion of well:			
(1) Diameter <u>2 1/2</u> inches.			
(2) Total Depth <u>60</u> feet.			
(3) Water Level <u>42'</u> feet below top of ground.			
(4) Cased to <u>55</u> , Size <u>2"</u>			
(5) Screen: Size <u>1 1/4</u> , Length <u>5' 55</u>			
(6) Were any formations sealed against pollution? <u> </u> yes, <u> </u> no.			
If YES depth of formation <u> </u>			
Why <u> </u>			
Drillers Remarks: <u> </u>			
<u> </u>			
<u> </u>			
<u> </u>			

0052

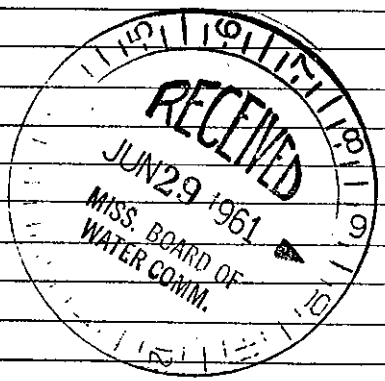

27

Well No.

(Use Back Side)

Retain this copy for your office files.