

WATER COMMISSIONERS

WATER WELL DRILLERS LOG

DeSoto

Date: ~~2-12~~, 1962, Driller: H & H Well Co County DeSoto


H. Henderson - (Name) Geo Hyde

(1) Owner of Land	Description & Color of Materials Sand, Clay, Red Clay, Shell, etc.	Thick- ness Feet	Depth Feet
M.O. Hamm (Name)	Red clay	22	184
Charrono RFD (Address)	Red sand-ground	46	
(2) Location: 1/4, 1/4, Sec. T. R.	Blue clay	44	
Coopram Road	Grey sand	50	
5 miles NE of Herronda (distance) (direction) (Nearest Town)	White sand	22	
(3) Topography: X (Hilly) (Flat) (Level)			184
(4) Purpose of Well: Home (Domestic Irrigation Municipal, Industrial, Other)			

Information upon completion of well:

- (1) Diameter 2 inches.
- (2) Total Depth 184 feet.
- (3) Water level 085 feet below top of ground.
- (4) Cased to 178, Size 2
- (5) Screen: Size 1/4, Length 6 -
- (6) Were any formations sealed against pollution?
_____ yes, _____ no.

Rod Pump		
# 0052		
40 ga		

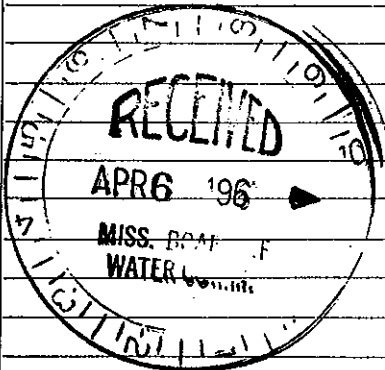

(Use Back Side)

22 Well No.

Mail this copy to Board of Water Commissioners 429 Miss. St. Jackson, Miss