

DeSoto MISSISSIPPI BOARD OF WATER COMMISSIONERS

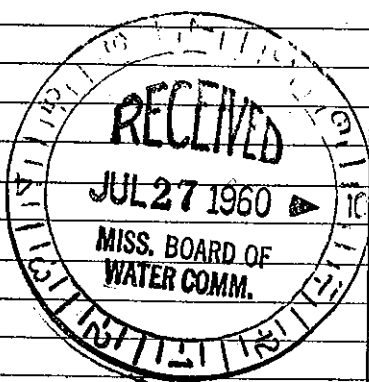
K-300

K 66
7-15-60

WATER WELL DRILLERS LOG **CODED**

Date: July 15, 1960, Driller: Deep South Well Co. County DeSoto

(Name)

(1) Owner of Land: <u>P. A. Gates, Jr.</u> <small>(Name)</small>	Description & Color of Materials Sand, Clay, Red Clay, Shell, etc.	Thick- ness Feet	Depth Feet
<u>R F D, Hernando, Miss.</u> <small>(Address)</small>	<u>0-25 Surface Clay</u>	<u>25</u>	
(2) Location: <u>1/4</u> , <u>1/4</u> , Sec. <u>1</u> T. <u>4</u> R. <u>8</u> ,	<u>25-68 Sand & Gravel</u>	<u>43</u>	
<u>4</u> miles <u>So.</u> , of <u>Hernando</u> <small>(distance) (direction) (Nearest Town)</small>	<u>68-69 Hard Rock</u>	<u>1</u>	
(3) Topography: <u>Hilly</u> <small>(Hilly) (Flat) (Level)</small>	<u>69-74 Yellow sandy clay</u>	<u>5</u>	
(4) Purpose of Well: <u>Domestic</u> <small>(Domestic Irrigation Municipal, Industrial, Other)</small>	<u>74-108 Blue Clay</u>	<u>34</u>	
	<u>108-140 Fine Sand</u>	<u>32</u>	
	<u>140-149 Med. Coarse Sand</u>	<u>9</u>	
	<u>149-159 Coarse & Med. Coarse Sand</u>	<u>10</u>	
Information upon completion of well:			
(1) Diameter <u>3</u> inches.	CODED		
(2) Total Depth <u>159</u> feet.	ODED		
(3) Water Level <u>107</u> feet below top of ground.			
(4) Cased to <u>None</u> , Size _____			
(5) Screen: Size <u>2"-.008</u> slot, Length <u>7 ft.</u>			
(6) Were any formations sealed against pollution? <u>no</u> yes, <u>x</u> no.			
If YES depth of formation _____			
Why _____			
Drillers Remarks: <u>None</u>			
			Well No.

(Use Back Side)

Mail this copy to Board of Water Commissioners 429 Miss. St. Jackson, Miss