

Desoto

MISSISSIPPI BOARD OF WATER COMMISSIONERS

K 67

9-14-60

WATER WELL DRILLERS LOG


CODED

K-307

Date: Sept. 14, 1960, Driller: Deep South Well Co. County Desoto
(Name)

(1) Owner of Land	Description & Color of Materials Sand, Clay, Red Clay, Shell, etc.	Thick- ness Feet	Depth Feet
<u>Mrs. Laurie M. Baxter</u> (Name)	<u>0-20 Surface clay</u>	<u>20</u>	
<u>Hernando, Miss.</u> (Address)	<u>20-55 Sand & gravel</u>	<u>35</u>	
(2) Location: <u>1/4</u> , <u>1/4</u> , Sec. <u>1</u> T. <u>4</u> R. <u>8</u>	<u>55-95 Yellow clay</u>	<u>40</u>	
<u>3 1/2</u> miles <u>south</u> , of <u>Hernando</u> (distance) (direction) (Nearest Town)	<u>95-110 Fine sand, clay streaks</u>	<u>15</u>	
(3) Topography: <u>Hilly</u> (Hilly) (Flat) (Level)	<u>110-140 Fine sand</u>	<u>30</u>	
(4) Purpose of Well: <u>Domestic</u> (Domestic Irrigation Municipal, Industrial, Other)	<u>140-149 Med. coarse sand</u>	<u>9</u>	
Information upon completion of well:	<u>149-158 Coarse & Med. coarse</u>	<u>9</u>	
(1) Diameter <u>2 1/2</u> inches.			
(2) Total Depth <u>158</u> feet.			
(3) Water Level <u>100</u> feet below top of ground.			
(4) Cased to <u>None</u> , Size _____			
(5) Screen: Size <u>1 1/2</u> , Length <u>8 ft</u>			
(6) Were any formations sealed against pollution? _____ yes, _____ no.			
If YES depth of formation _____			
Why _____			
Drillers Remarks: <u>None</u>			

CODED

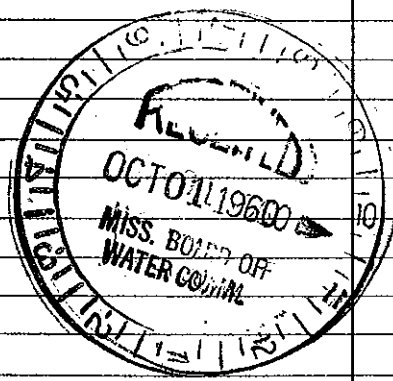

Well No.

(Use Back Side)

Mail this copy to Board of Water Commissioners 429 Miss. St. Jackson, Miss