

DESOTO MISSISSIPPI

K 68

10-27-60

WATER WELL DRILLERS LOG

Date: 10-27, 1960, Driller: A.A. Jenderson

CODED


(Name)

(1) Owner of Land: <u>Jodie Clompit</u> (Name)	Description & Color of Materials Sand, Clay, Red Clay, Shell, etc.	Thick- ness Feet	Depth Feet
<u>RT 1 Hammond miss</u> (Address)	<u>44' Clay Red sand + gravel</u>	<u>44</u>	<u>68'</u>
(2) Location: <u>1/4, 1/4, Sec. 18, T. 3R. 8,</u> <u>5 miles West of Hammond</u> (distance) (direction) (Nearest Town)	<u>white sand & pebbles gravel</u>	<u>10 18</u>	
(3) Topography: <u>X</u> (Hilly) (Flat) (Level)			
(4) Purpose of Well: (Domestic Irrigation Municipal, Industrial, Other)			

CODED

Information upon completion of well:

- (1) Diameter 2 inches. PLASTIC
- (2) Total Depth 68' feet. 60.52
- (3) Water Level 50' feet below top of ground.
- (4) Cased to 68, Size 2"
- (5) Screen: Size 1/4, Length 6' 60%
- (6) Were any formations sealed against pollution?
_____ yes, _____ no.

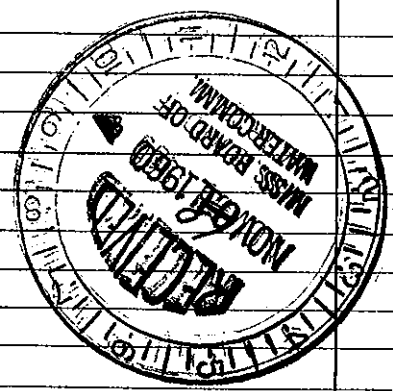

If YES depth of formation _____

Why _____

Drillers Remarks: _____

13

Well No.

(Use Back Side)

Retain this copy for your office files.