

Desoto MISSISSIPPI BOARD OF WATER COMMISSIONERS

K 72
2-6-62

WATER WELL DRILLERS LOG

CODED

Date: Feb. 6, 19 62, Driller: Deep South Well Co., DeSoto
(Name)

(1) Owner of Land: <u>W. H. Manning</u> (Name)	Description & Color of Materials Sand, Clay, Red Clay, Shell, etc.	Thick- ness Feet	Depth Feet
<u>Hernando, Miss.</u> (Address)	0-20 Surface Clay	20	
(2) Location: <u>1/4, 1/4, Sec. 17, T4R8,</u> <u>4 miles S.W. of Love</u> (distance) (direction) (Nearest Town)	20-26 Red Sand	6	
(3) Topography: <u>Hilly</u> (Hilly) (Flat) (Level)	26-45 Buck shot	19	
(4) Purpose of Well: <u>Domestic</u> (Domestic Irrigation Municipal, Industrial, Other)	45-63 Red sandy clay	18	
	63-70 White sandy clay	7	
	70-78 Sand, gravel, clay	8	
	78-140 White sticky ^{strks} clay	62	
	140-145 Fine sand	5	
	145-154 Med. Coarse sand	9	


Information upon completion of well:

- (1) Diameter 2" inches.
- (2) Total Depth 154 feet.
- (3) Water Level 65 feet below top of ground.
- (4) Cased to None, Size _____.
- (5) Screen: Size 1 1/2", Length 6 ft.
- (6) Were any formations sealed against pollution?
_____ yes, No no.

If YES depth of formation _____

Why _____

Drillers Remarks: _____

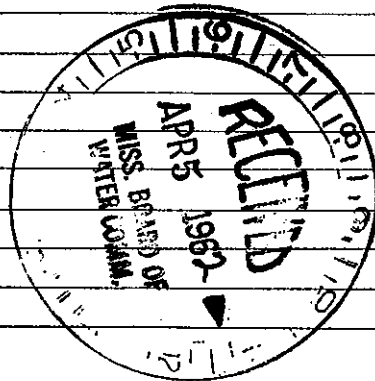

(Use Back Side)

Well No.

Mail this copy to Board of Water Commissioners 429 Miss. St. Jackson, Miss.