

Desoto

K 73

5-3-62

Date 5-3-62

WATER WELL DRILLERS LOG

Drillers H H Wells County Desoto

CODED


(1) Owner of Land	Description & Color Materials	Thickness Feet	Depth Feet
Lynna Baker RT 1 Hermando	red clay	25	68
Location: 1/4, 1/4, Sec. 8 T. 38 R. 10	red sand	15	
5 miles West Hermando	sand + gravel	28	
(3) Topography: Hilly (Flat) (Level)			
(4) Purpose of Well: Home (Domestic Irrigation, Municipal, Industrial, Other)			

Information upon completion of well:

CODED

- (1) Diameter 2 inches.
- (2) Total Depth 68 feet.
- (3) Water Level 51 feet below top of ground.
- (4) Cased to 62, Size 2.
- (5) Screen: Size 1/4, Length 6.
- (6) Were any formations sealed against pollution?  
yes, no.

Red Pump

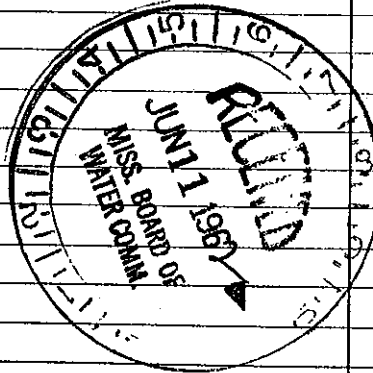

If YES depth of formation \_\_\_\_\_

Why \_\_\_\_\_

Drillers Remarks: \_\_\_\_\_

Well No. 11

Retain this copy for your office files.

(Use Back Side)