

*DeSoto*  
*K76*  
*4-67*

MISSISSIPPI  
 BOARD OF WATER COMMISSIONERS  
 416 North State Street  
 Jackson, Mississippi 39201

**CODED**

WATER WELL DRILLERS LOG

*4* date well completed    *1967* firm name *Harris Bros*    *DeSoto* county well located

LANDOWNER: *Jimmy Richardson*  
*Richardson*  
*Rte. 2 Hernando*  
 (mailing address)


description of formations encountered	from	to
<i>top soil</i>	<i>0</i>	<i>20</i>
<i>red sand</i>	<i>20</i>	<i>50</i>
<i>clay + sand</i>	<i>50</i>	<i>95</i>
<i>coarse sand</i>	<i>95</i>	<i>107</i>

WELL LOCATION:  
 sec *14* T *4* N R *8* E  
*10* miles *NW* of *Caldwater*  
 (distance) (direction) (nearest town)

WELL PURPOSE: *home*  
 (home, irrigation, municipal, industrial)

- WELL COMPLETION DATA:
- diameter (inches) *4*
  - total depth (feet) *107*
  - static water level (feet) *80* below above top of ground.
  - casing *plastic*, *100* (material) (depth)  
*4"* (size) If telescope see back.
  - screen *7'*, *100* (length) (depth to top)  
*.008*, *plastic* (size) (material)
  - pump *3/4*, *7* (HP) (yield gpm)  
*elec.* (type power)
  - electric log *no* (yes or no)  
 (organization running log)
  - how well bottom plugged *truck*  
*shot*

**CODED**

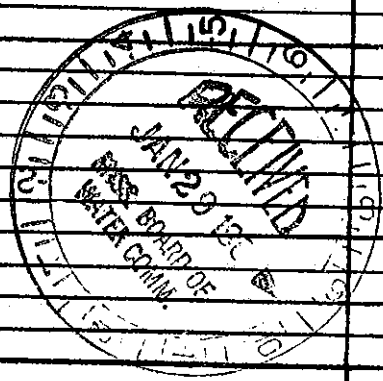

DRILLERS REMARKS: