

Results  
K 80  
9-12-68

MISSISSIPPI  
BOARD OF WATER COMMISSIONERS  
416 North State Street  
Jackson, Mississippi 39201

WATER WELL DRILLERS LOG **CODED**

Sept 12, 1968 *Bumpas Well Co* *Madison*  
date well completed firm name county well located

LANDOWNER: *Clifton H Deane*  
*4109 Moby Road*  
*Memphis, Tenn*  
(mailing address)


description of formations encountered	from	to
<i>Clay</i>	<i>0</i>	<i>30</i>
<i>Sand &amp; gravel</i>	<i>30</i>	<i>180</i>

WELL LOCATION:  
sec. *16* T. *3* N. R. *8* E  
*3* miles *West* of *Hernando*  
(distance) (direction) (nearest town)

WELL PURPOSE:  
(home, irrigation, municipal, industrial)

- WELL COMPLETION DATA:
- (1) diameter (inches) *4"*
  - (2) total depth (feet) *180*
  - (3) static water level (feet) *100* below above top of ground.
  - (4) casing *Plastic, 173 ft*  
(material) (depth)  
*4"*  
(size) if telescope see back.
  - (5) screen *9 ft, 173 ft*  
(length) (depth to top)  
*4"* *gravel wall*  
(size) (material)
  - (6) pump *3/4* *10*  
(HP) (yield gpm)  
*Electric*  
(type power)
  - (7) electric log (yes or no)
  - (organization running log)
  - (8) how well bottom plugged *4" cap*

**CODED**

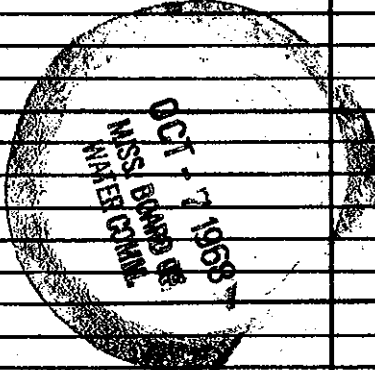

DRILLERS REMARKS: